


# T. 39S. R. 8 W. W.M.

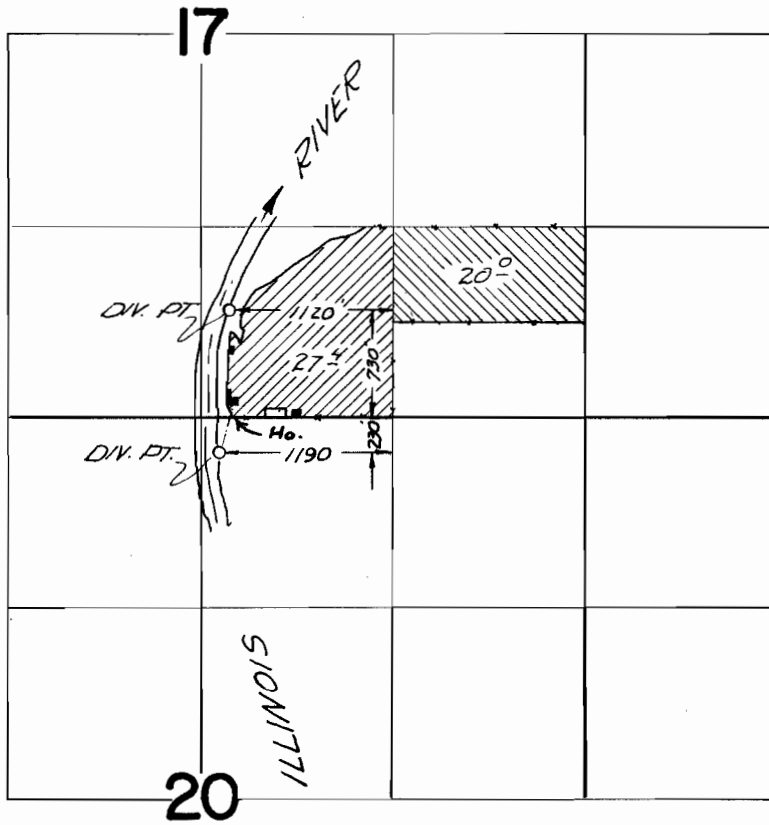

## FINAL PROOF SURVEY UNDER

Application No. 37416 39081 Permit No. 27866 29173  
IN NAME OF

CHARLES NEIL VERSTEEG

Surveyed May 17 1967, by V. Gardner