


T.39S. R.8W. W.M.

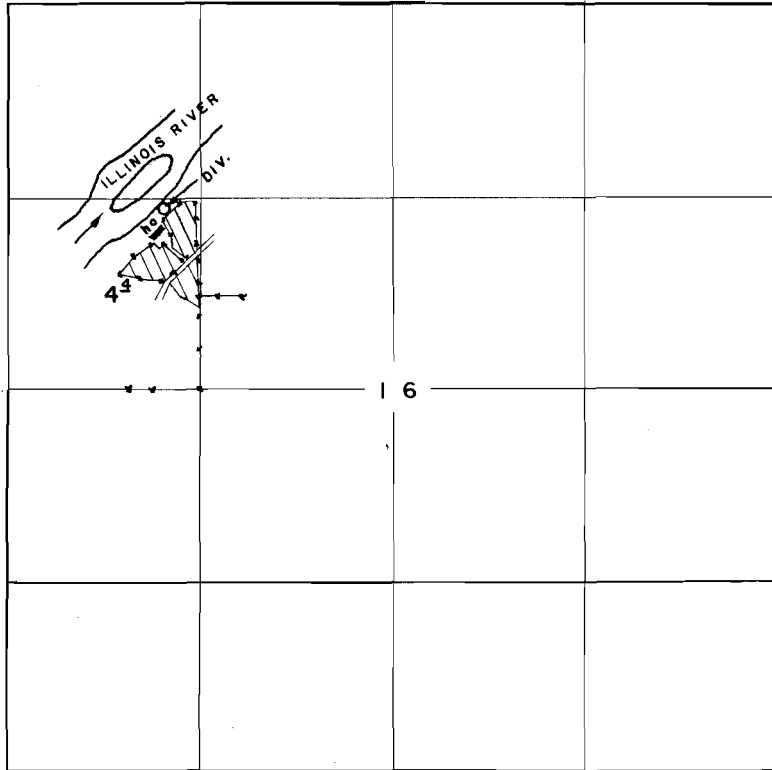

DIV. PT. LOCATED 124.0 FT. N. & 260 FT. W. FROM SE COR.

FINAL PROOF SURVEY
UNDER

Application No. 39929... Permit No. 29719...
IN NAME OF

.....
WILMER T. WHITE
.....

Surveyed NOV. 7... 1967, by R.B. STEIMER.....