


T.37S. R.5W.W.M.

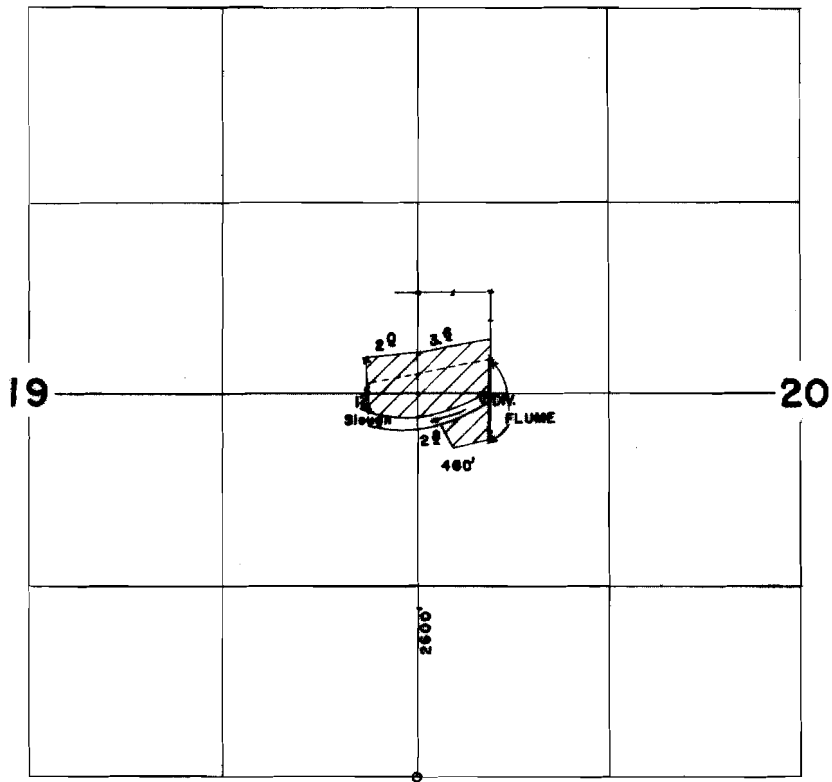

FINAL PROOF SURVEY UNDER

Application No. 41553..... Permit No. 30996...
IN NAME OF

.....OWEN W. HALE.....

Surveyed MAY.10. 1968, by R.B.STEIMER...