
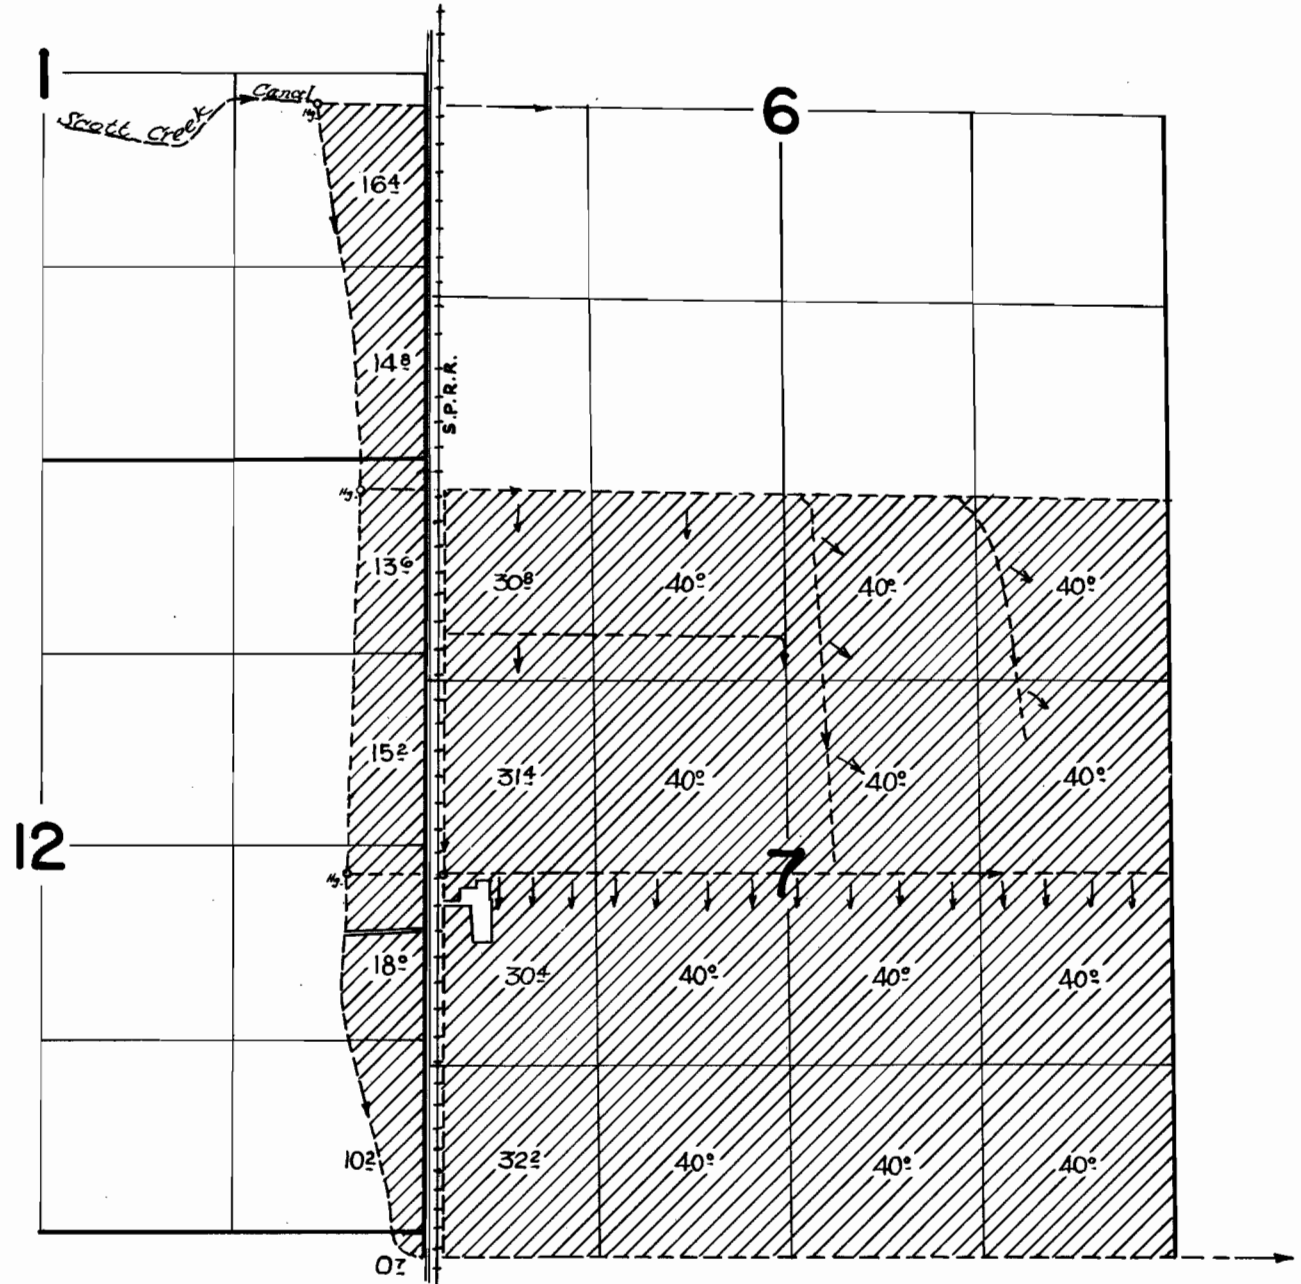


T. 31 S. R. 7 E. W.M.

T. 31 S. R. 7 & 8 E. W.M.

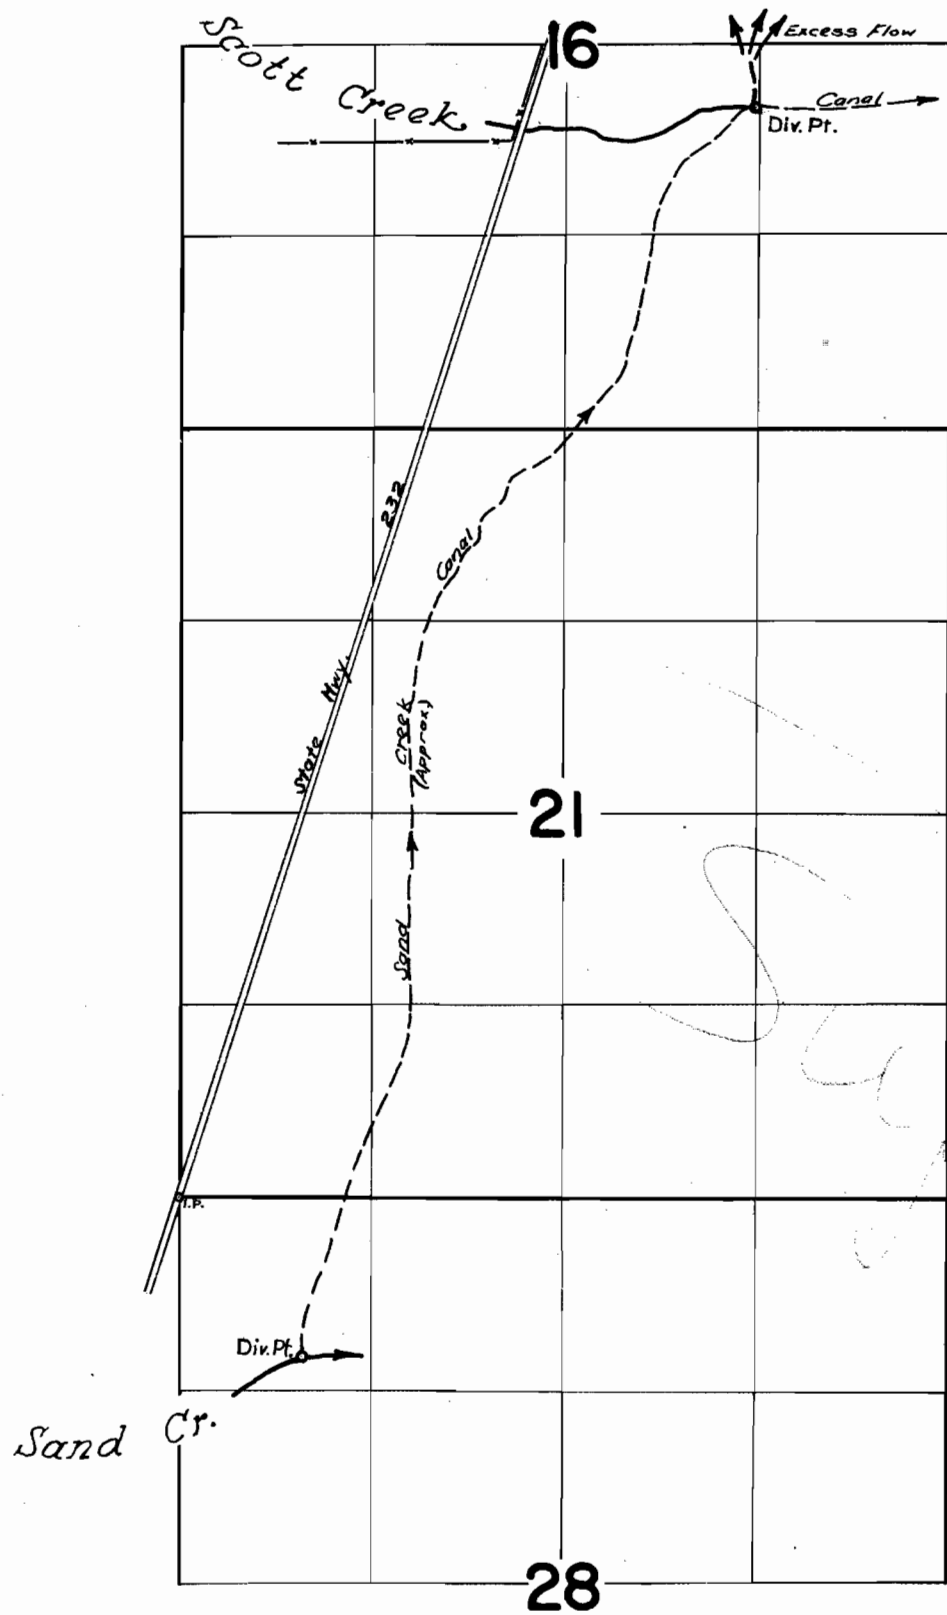

FINAL PROOF SURVEY

UNDER
Application 30003 Permit 25987
IN NAME OF

F. MILES & VIRGINIA E. MAYFIELD

Surveyed August 18, 1962 by R. H. Jackson