


Williamson River

T. 30 S. R. 10 & 11 E. W. M.

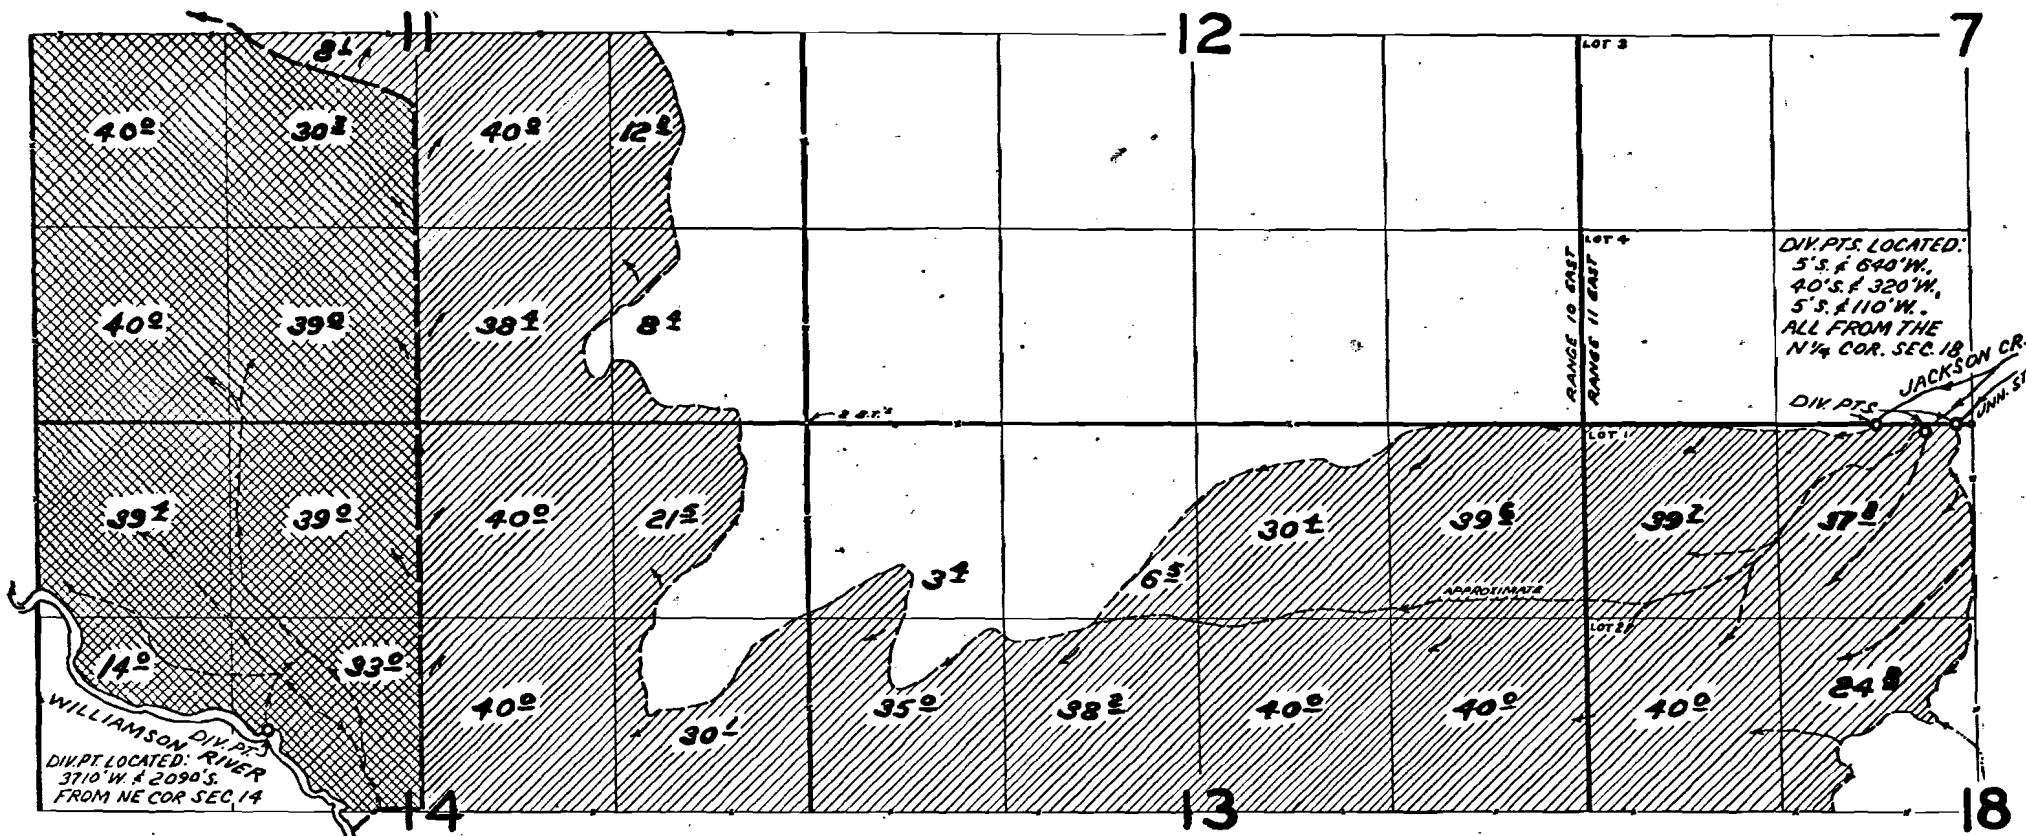

DIV. PTS. LOCATED:  
 5'S. & 640' W.,  
 40'S. & 320' W.,  
 5'S. & 110' W.,  
 ALL FROM THE  
 N 1/4 COR. SEC. 18

WILLIAMSON DIV. PTS.  
 DIV. PT. LOCATED: RIVER  
 3710' W. & 2090' S.  
 FROM NE COR. SEC. 14

PERMIT NO. 28003
  PERMIT NO. 28171

# FINAL PROOF SURVEY

UNDER

APPLICATION NO. 37574, PERMIT NO. 28171  
 37587 28003

IN NAME OF

## ESTATE OF MRS. ANNIE FRANCIS

SURVEYED JUN. 25, 1967, BY V. GARNER

28003  
 28171  
 34945  
 34946