


Williamson River

T. 30S. R. 10 & 11 E. W.M.

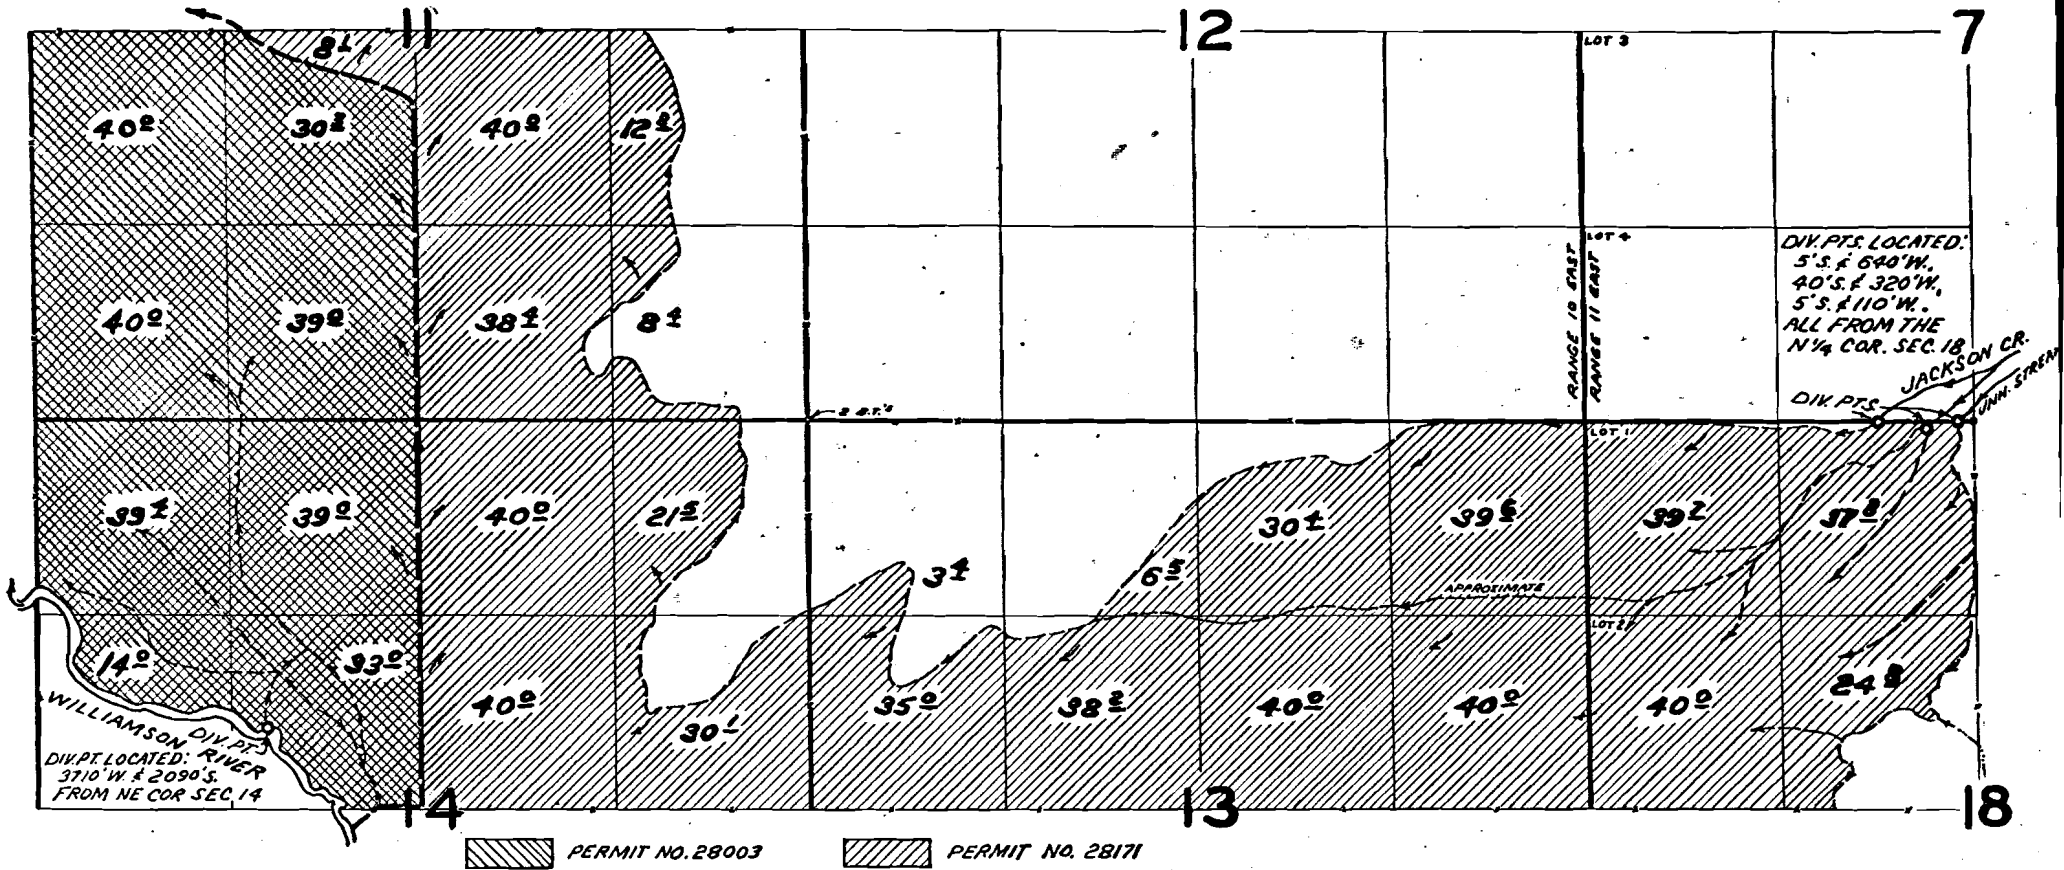

FINAL PROOF SURVEY

UNDER

APPLICATION NO. 37574, PERMIT NO. 28171
37587 28003

IN NAME OF

ESTATE OF MRS. ANNIE FRANCIS

SURVEYED JUN. 25, 1967, BY V. GARNER

28003
28171
34945
34946