


T. 16S. R. 5 E. W.M.

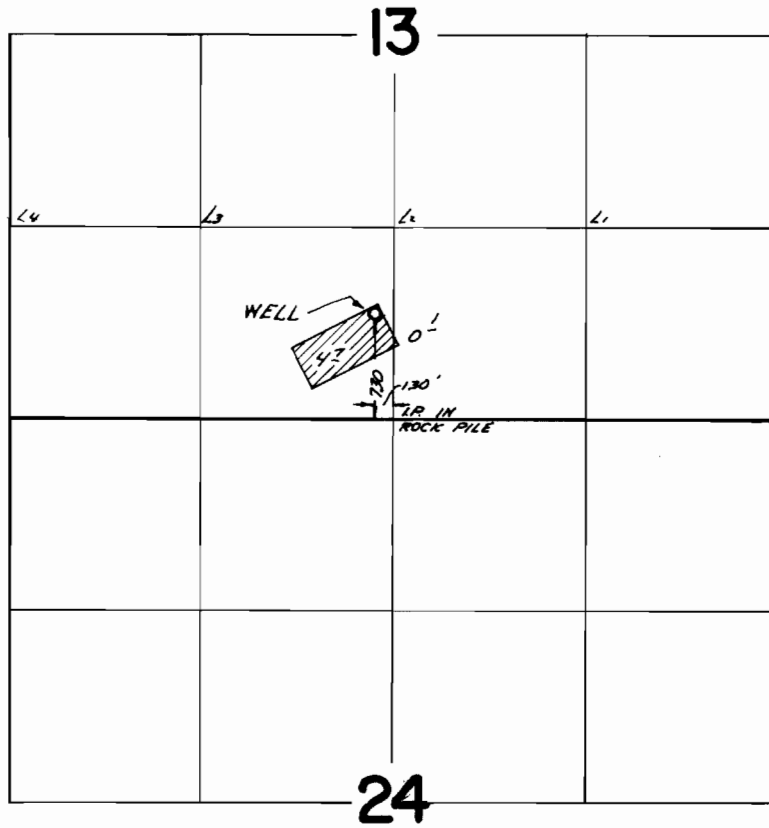

**FINAL PROOF SURVEY**  
UNDER

Application No. *G-2381*. Permit No. *G-2191*.  
IN NAME OF

.....*GIUSTINA BROS.*.....

Surveyed *June 13 1967*, by *V. Garner*.....