


R. 12 W

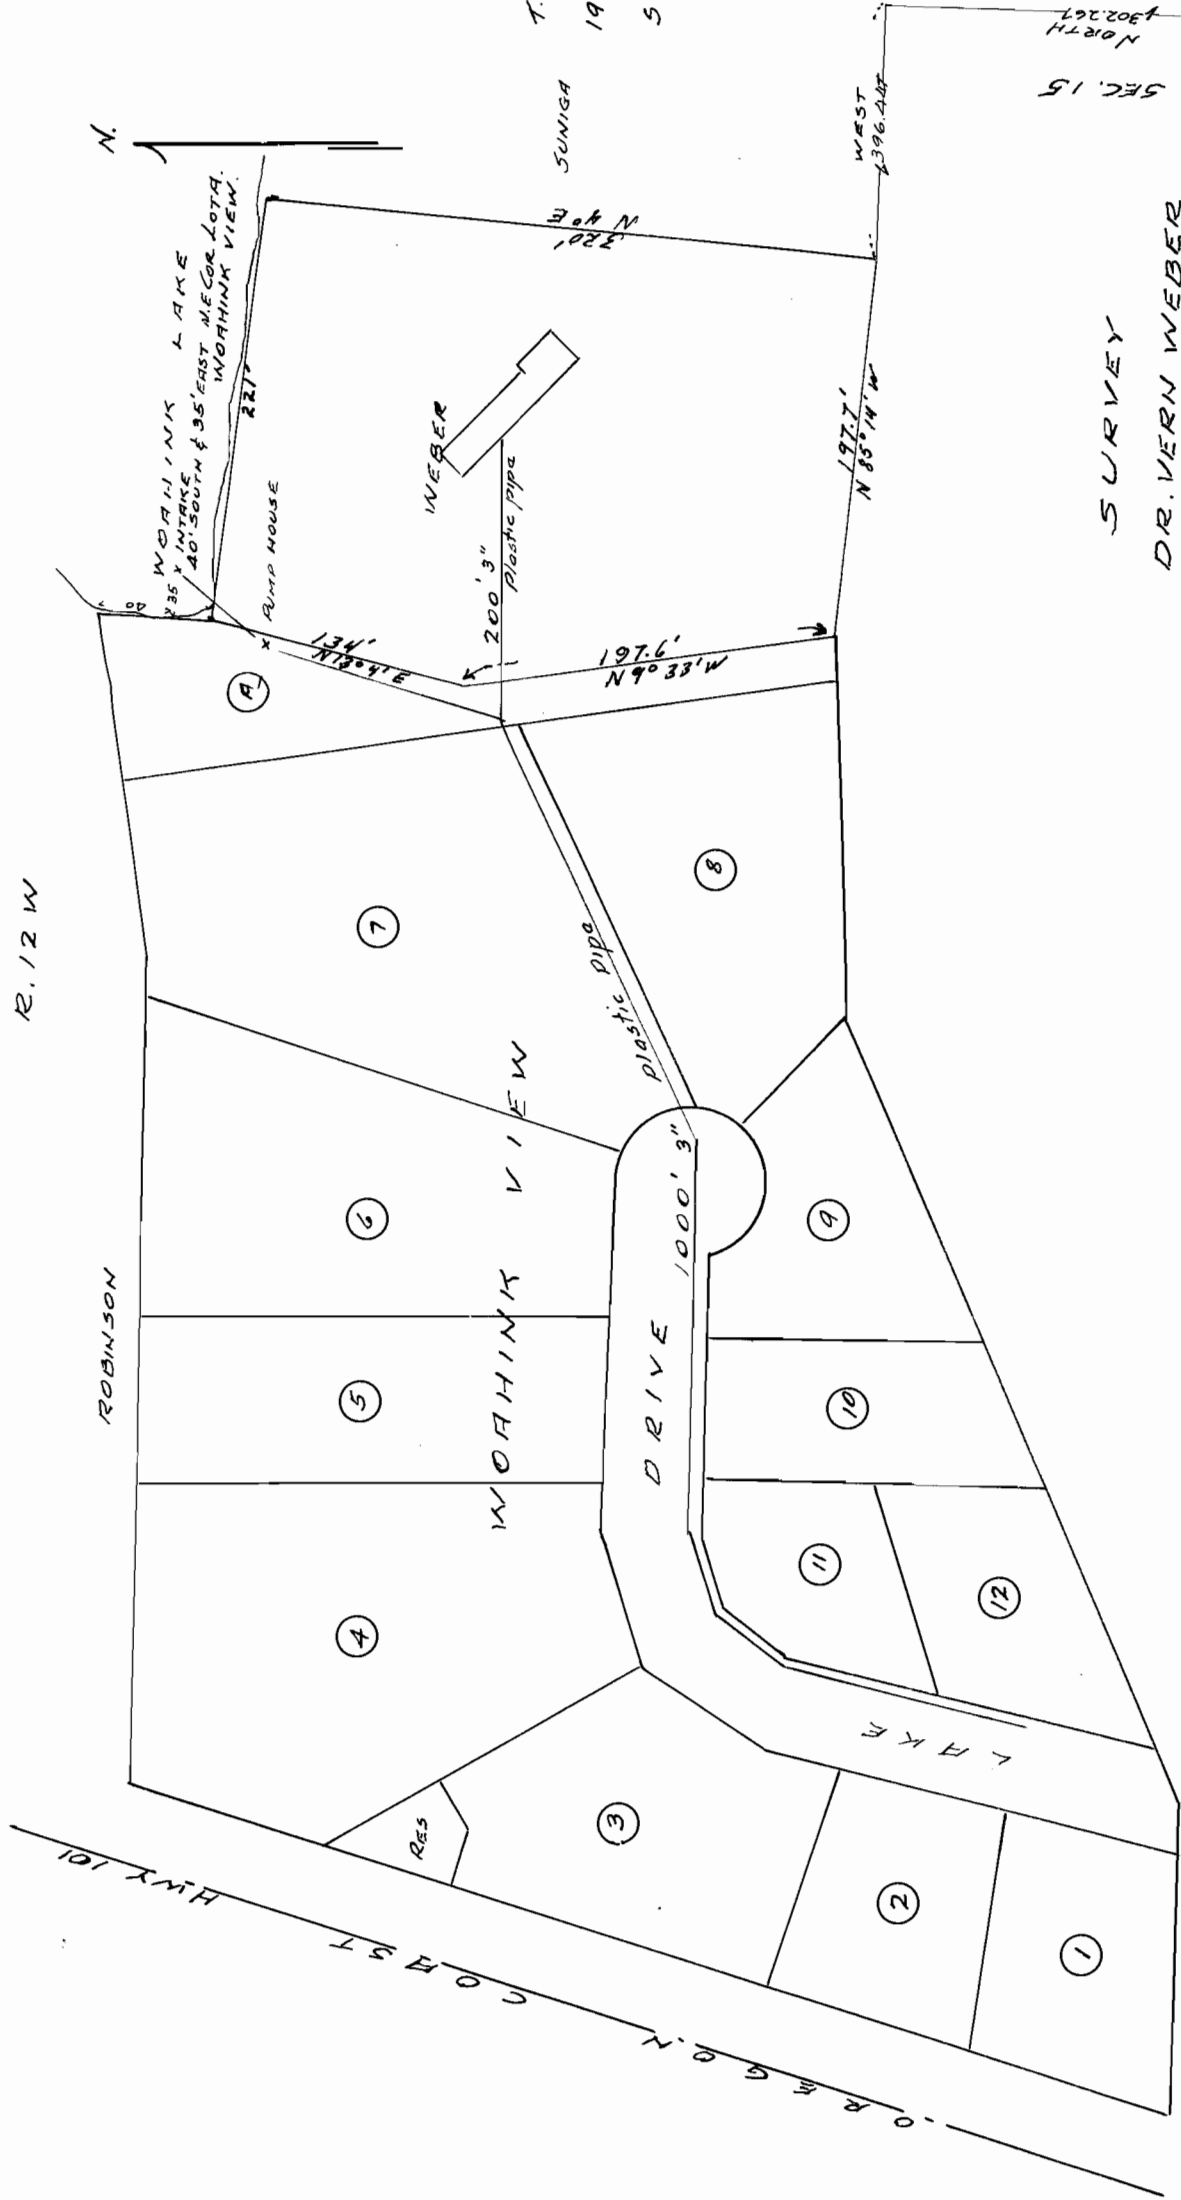

SURVEY  
 DR. VERN WEBER

SEC. 15, T. 19 S, R. 12 W. W.M.

LANE COUNTY

Scale 1"=100' Jan 60.

Cons. Mon  
 M.C. 2



Application No. 33598

Permit No. 26567

SEC. 15

SEC. 14

T. 19  
 5

SUNIGA

WEST  
 4396.44'

320' N 40° E

197.7' N 85° 14' W

197.6' N 9° 33' W

134' N 12° 41' E



WEBER

200' 3" Plastic pipe

Plastic pipe

DRIVE 1000' 3"


ROBINSON

RES

LAKE

COMST  
 HWY 101