


T.17 S.R.4 W.W.M.

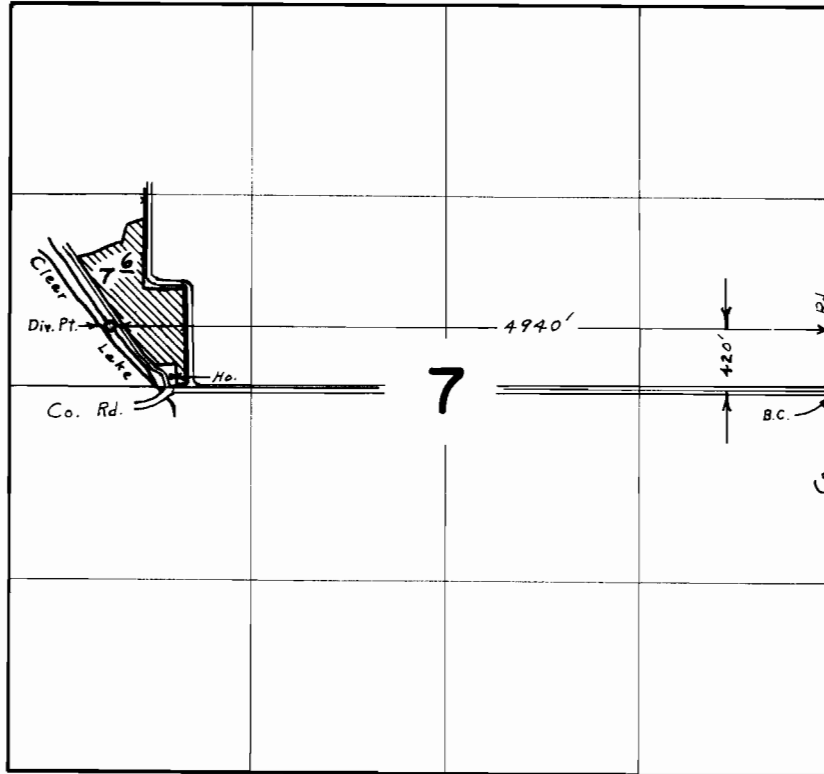

FINAL PROOF SURVEY UNDER

Application No. 34052 Permit No. 26845
IN NAME OF
GLENN & EDITH S. SNOOK

Surveyed April 28 1967, by L. E. Gould