


# T.17S. R.1E.W.M.

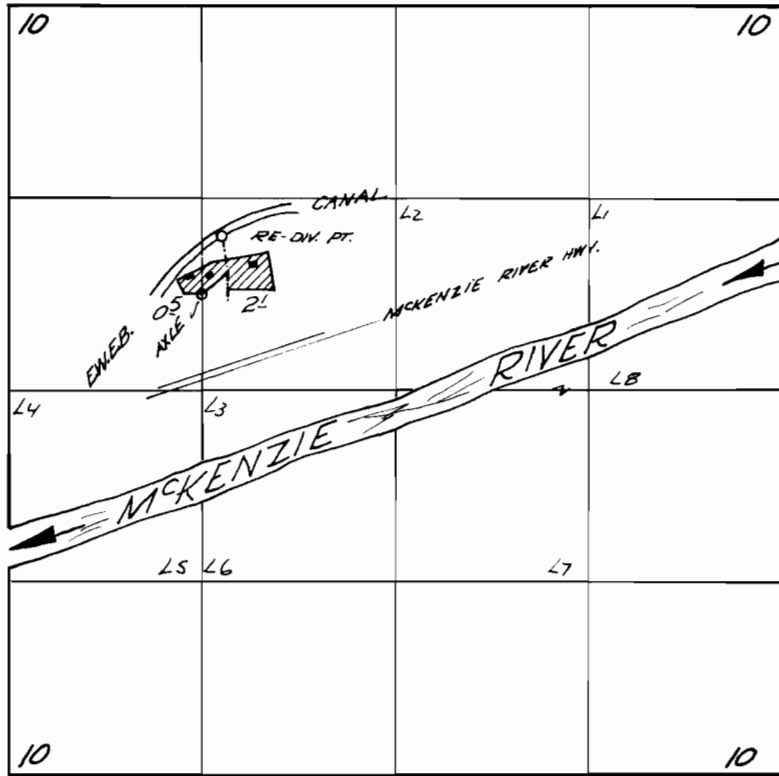

Re-Div. pt. located 400 ft. N. and 130 ft. E. from  
the SW. cor. of the N $\frac{1}{2}$  of the SE $\frac{1}{4}$  NW $\frac{1}{4}$  Sec. 10

## FINAL PROOF SURVEY UNDER

Application No. 34789... Permit No. 27325...  
IN NAME OF

HARRY J. MOORE

Surveyed June 15 1967, by V. Garner