


T.17S.R.1E.W.M.

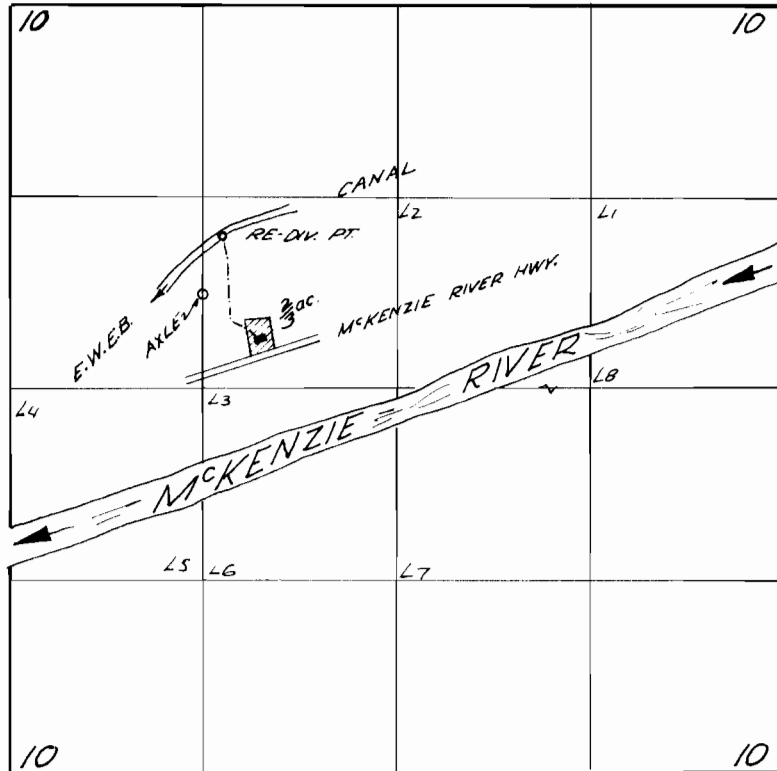

Re-Div. pt. located 400 ft. N. and 130 ft. E. from
the SW. cor. of the N $\frac{1}{2}$ of the SE $\frac{1}{4}$ NW $\frac{1}{4}$ Sec. 10

FINAL PROOF SURVEY UNDER

Application No. 37714 . Permit No. 28094
IN NAME OF

FLOYD CHESTER WILSON

Surveyed June 15, 1967, by *V. Garner*