


T. 19 S. R. 12 W. W.M.

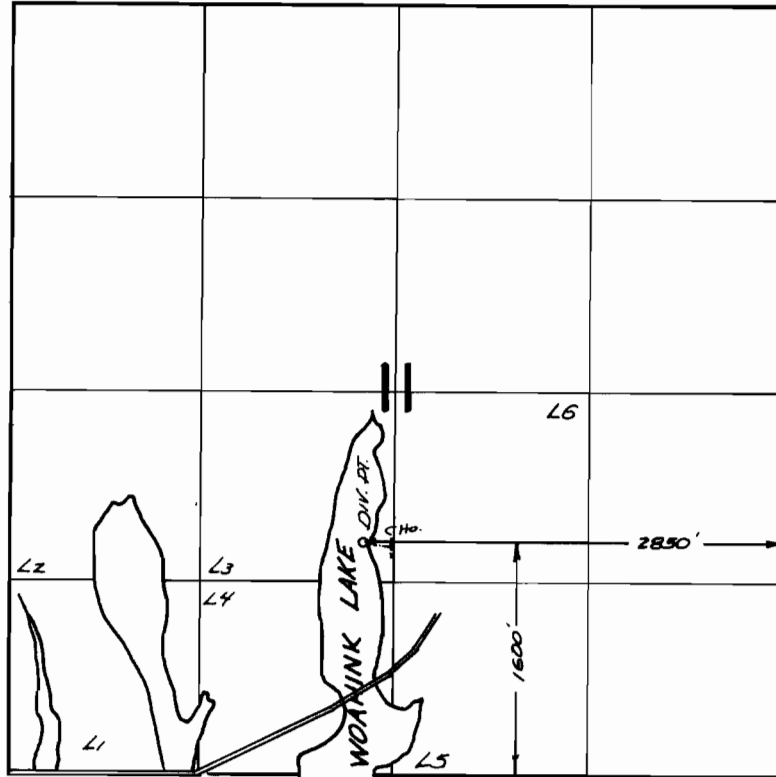

**FINAL PROOF SURVEY**  
UNDER

Application No. 39205. Permit No. 29154...  
IN NAME OF

*DR. E. S. STONG*

Surveyed *July 13, 1967*, by *V. Garner*