


STEPHEN H. FORD & ASSOCIATES

302 TIFFANY BUILDING
797 WILLAMETTE STREET

PHONE DI 4-1852
EUGENE, OREGON

S. H. FORD, PHONE DI 5-3935
Box 360, RT. 5, EUGENE

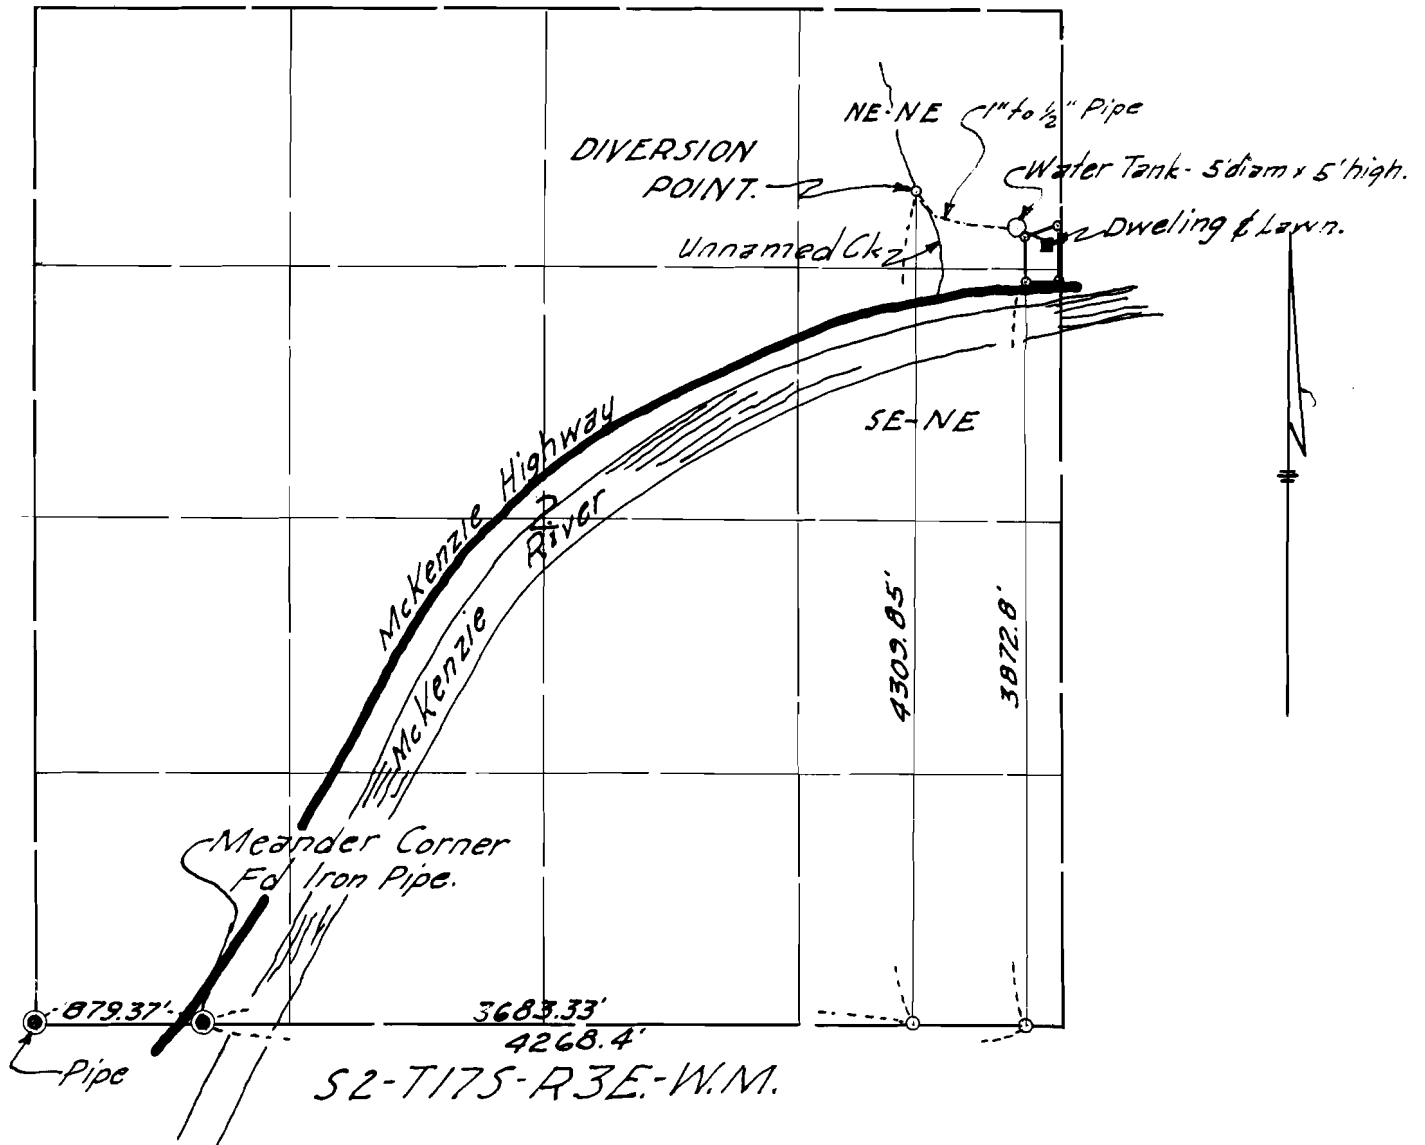

MAP FOR
ALBERT H. & FERNE. TOURTILLOTT.
S2-T175-R3E-W.M.
SCALE: 1"=1000' DEC 1963.

Application No. 39245
Permit No. 29239

DRAWN BY *SHF*

JOB NO 272.15