


T. 16 S. R. 4 E. W.M.

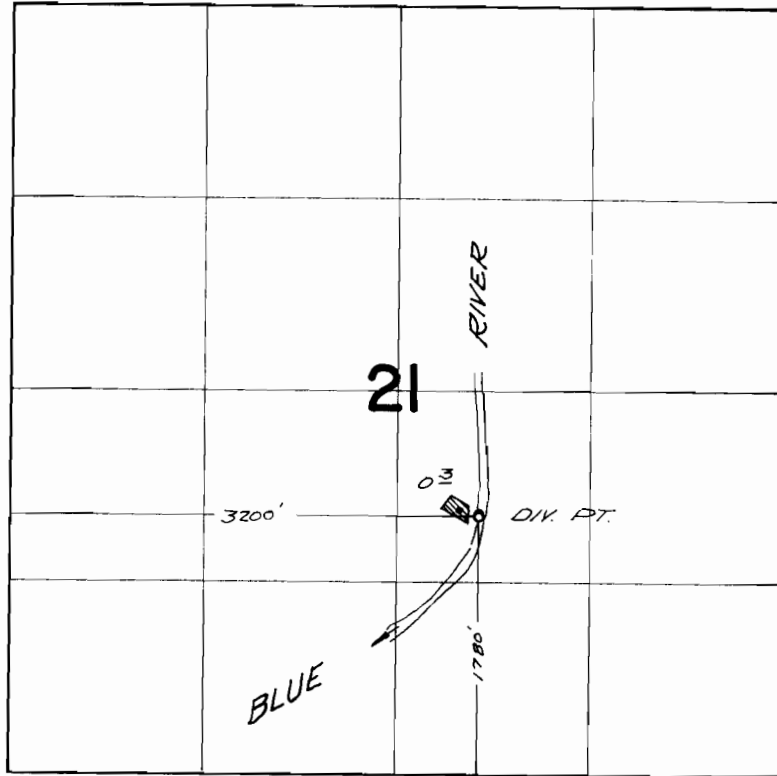

**FINAL PROOF SURVEY**  
UNDER

Application No. 39777 Permit No. 29575  
IN NAME OF

HERBERT A. SAIN

Surveyed June 12, 1967, by V. Garner

*Chain survey - notes on field form -*