


T. 17 S. R. 9 W. W.M.

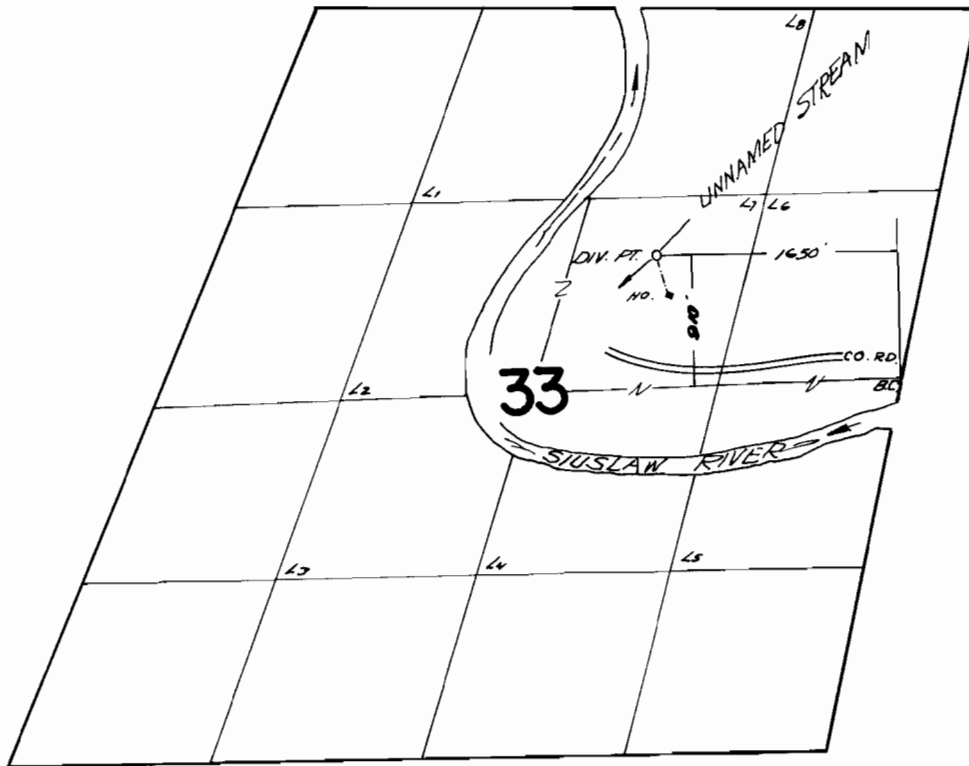

**FINAL PROOF SURVEY**  
UNDER

Application No. 41473 Permit No. 30962  
IN NAME OF

LOUIS and NORA OLSON

Surveyed July 14 1967, by V. Garner