


T.18 S.R.47 E.W.M.

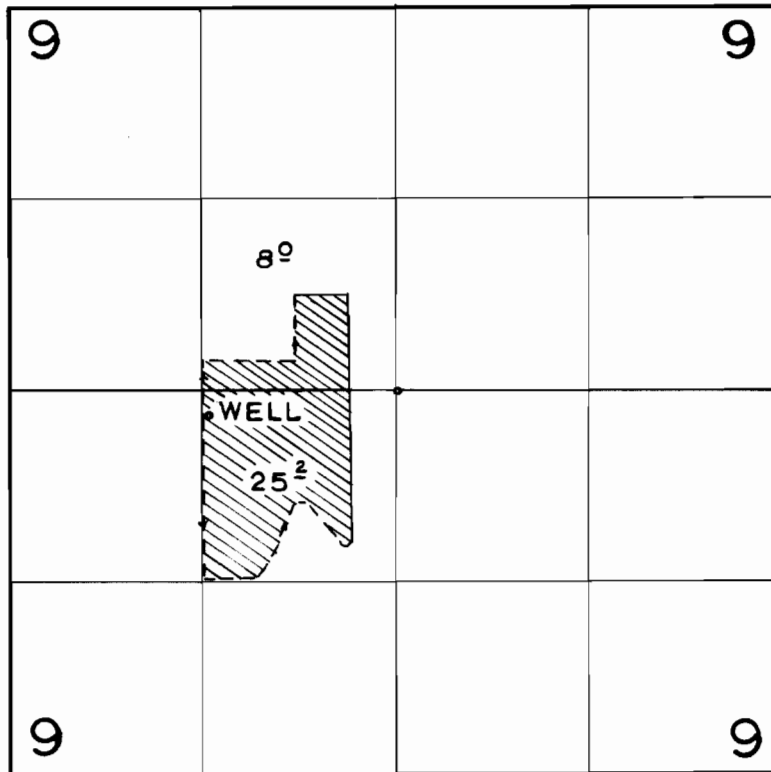

WELL IS 170' S. & 1290' W. FROM CENTER SEC. 9

**FINAL PROOF SURVEY**  
UNDER

Application No. G-2577. Permit No. G-2390.  
IN NAME OF

MRS. LLOYD URQUHART

Surveyed MARCH 10 1966, by FELFERING