


T. 5 S. R. 1 W. W. M.

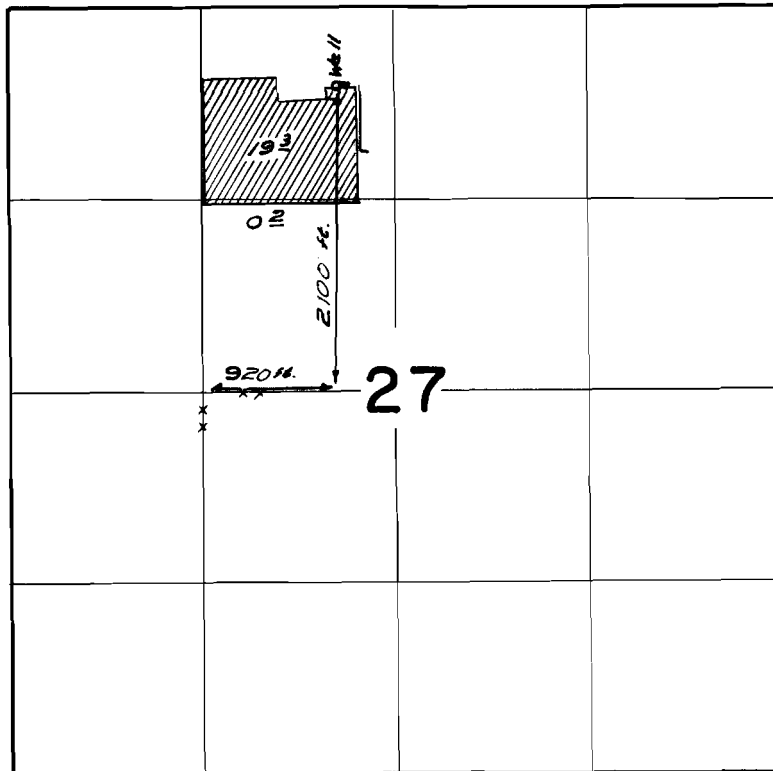

FINAL PROOF SURVEY UNDER

Application No. G-1926 Permit No. G-1770
IN NAME OF

Roy Dempsey

Surveyed Sept. 6 1966, by W. V. Ruppert