


T.7S. R.2W. W.M.

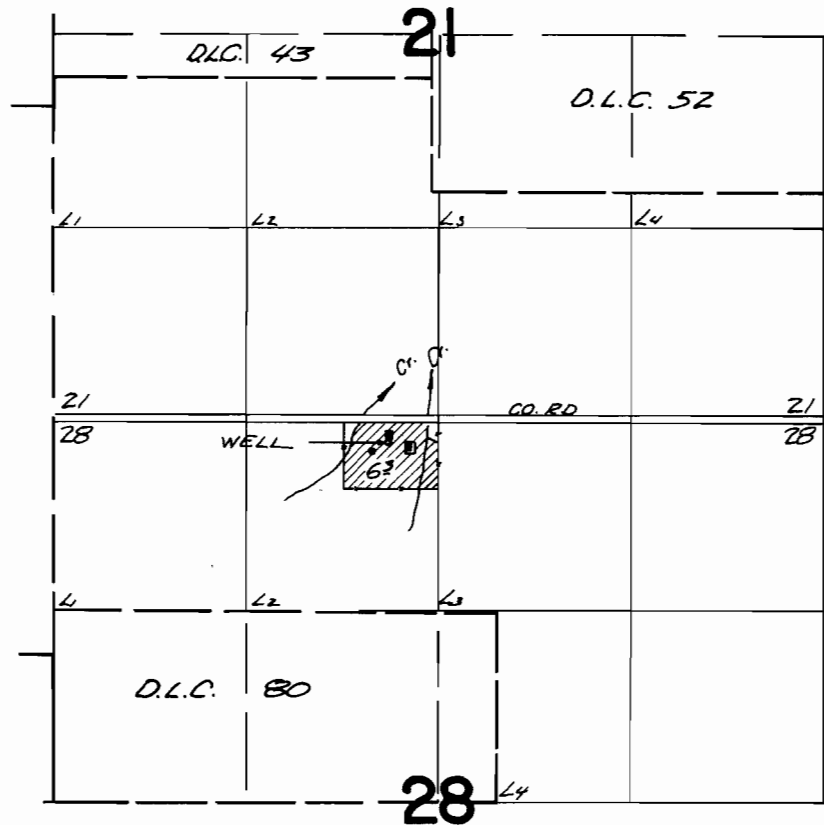

Well located 160 ft. S. and 340 ft. W.
from the N $\frac{1}{4}$ corner of Section 28

FINAL PROOF SURVEY UNDER

Application No. ~~G-2667~~ Permit No. ~~G-2472~~
IN NAME OF

MR. and MRS. MELVIN KLAMPE

Surveyed Nov. 20, 1967, by V. Garner