


T.7S. R.3 W. W.M.

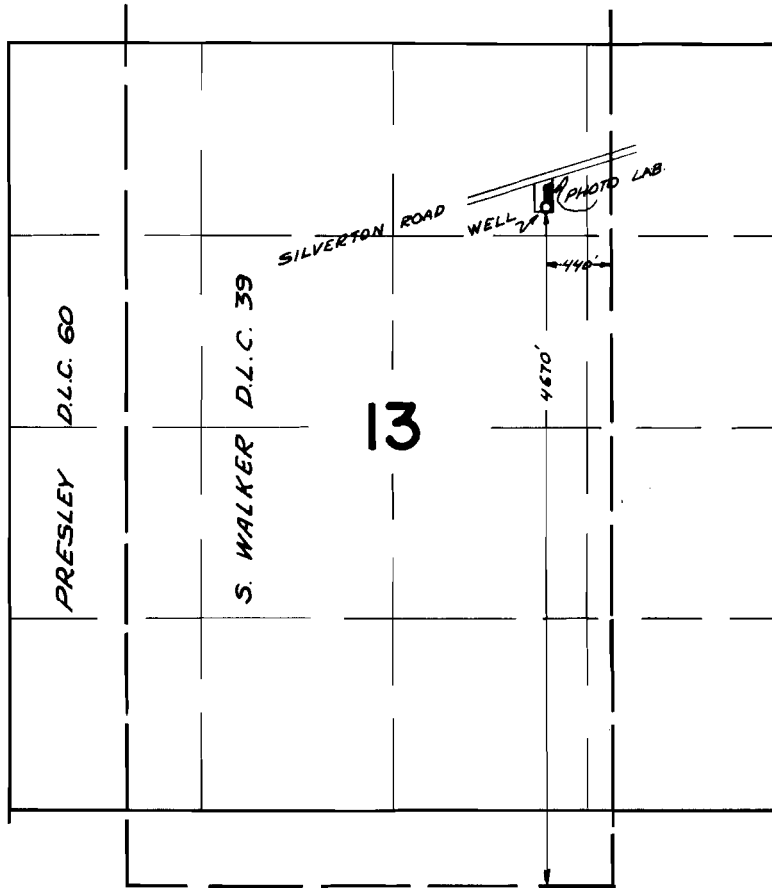

FINAL PROOF SURVEY UNDER

Application No. G-2806 Permit No. G-2721
IN NAME OF

M. A. ARTZ

Surveyed Nov. 22, 1967, by V. Garner