


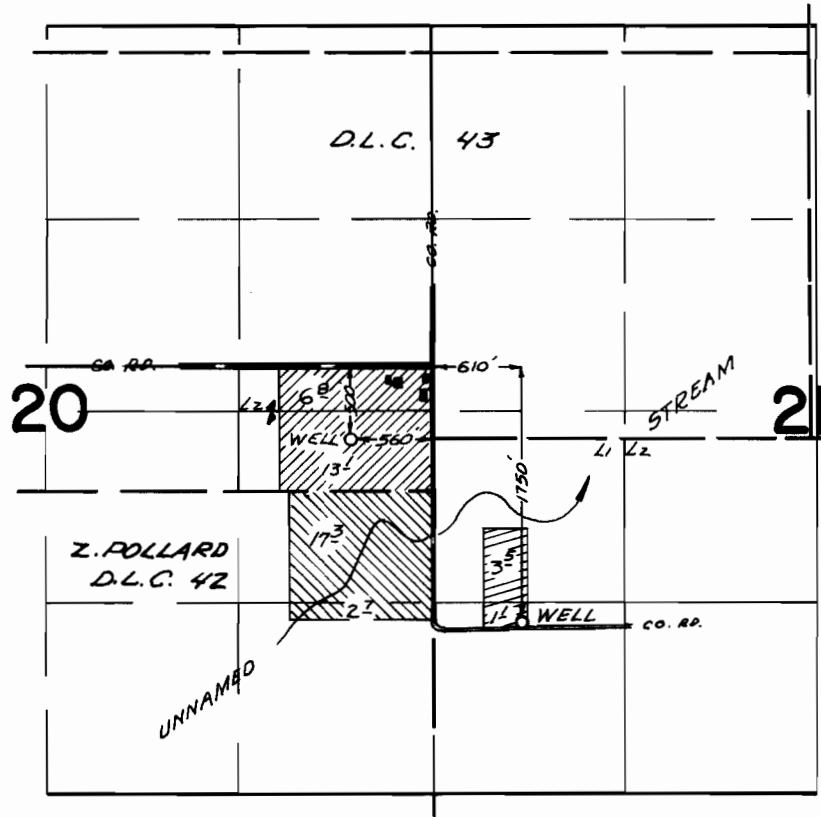


T. 7 S. R. 2 W. W.M.



FINAL PROOF SURVEY UNDER

G-3484

G-3284

-  PRIMARY
-  SUPPLEMENTAL
- 

Application No. G-3486 Permit No. G-3286
IN NAME OF

OTTO EMIL FOLK

Surveyed Nov. 22, 1967, by V. Garner