


T.6S.R.2W.W.M.

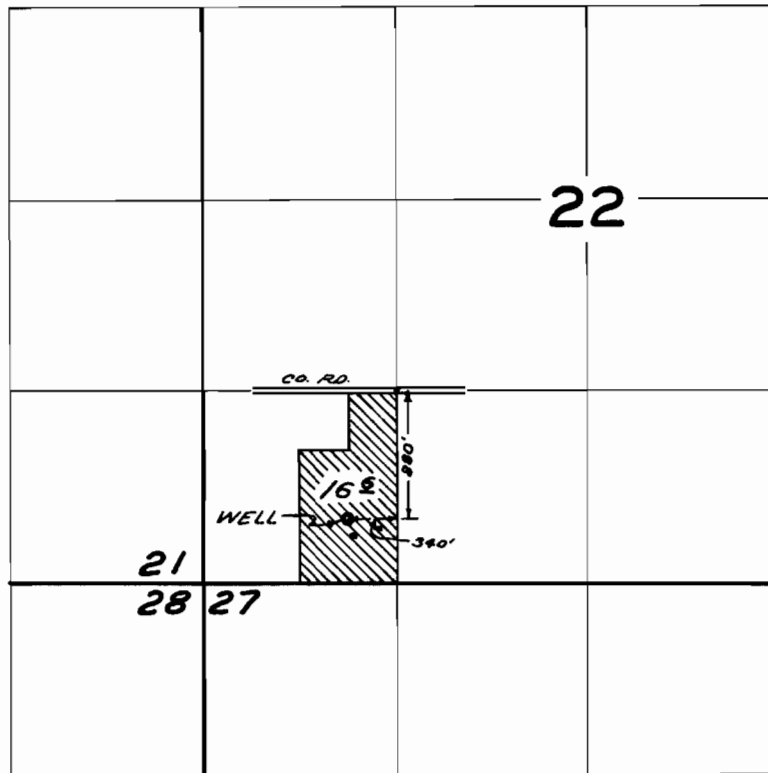

FINAL PROOF SURVEY
UNDER

Application No. G-3625 Permit No. G-3408
IN NAME OF

MILO RAY KIEWER

Surveyed Nov. 27 19.67, by W. J. RUPPERT