T.6 S. R.3 W. W.M.

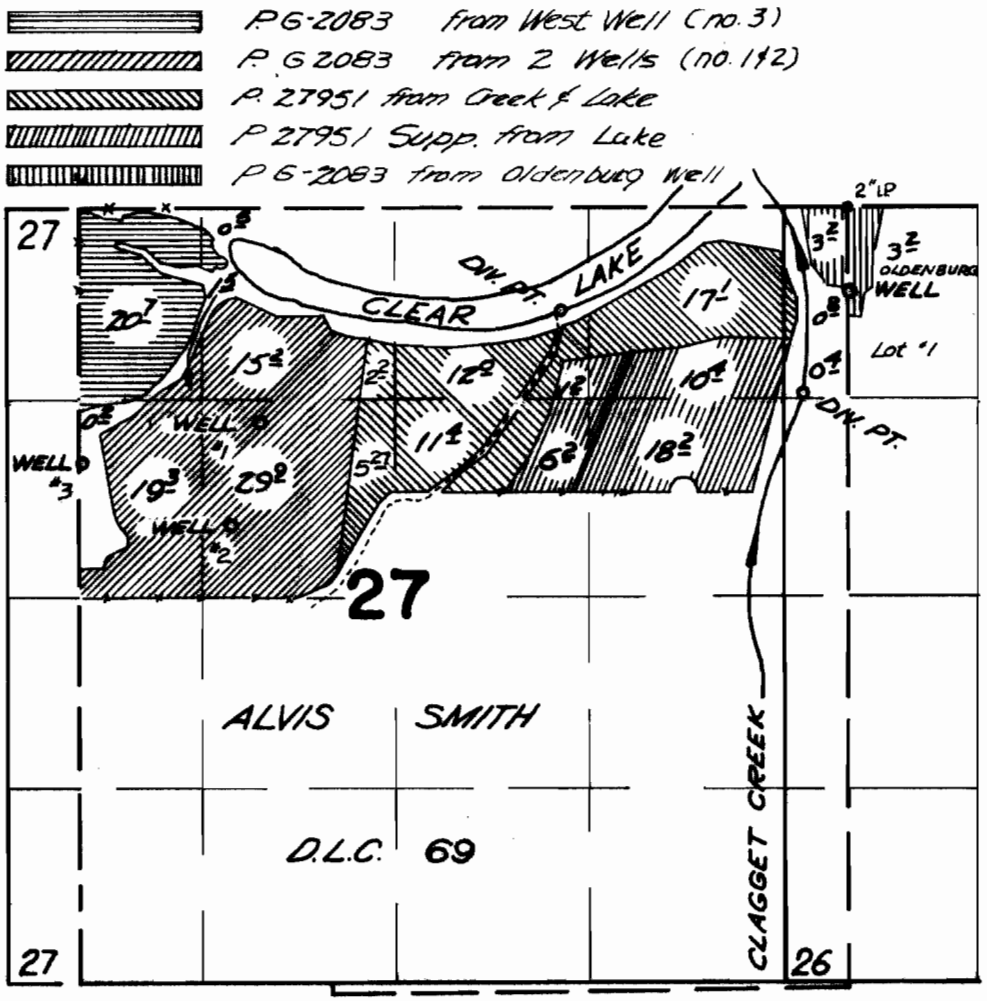

Wells 1, 2 & 3 located #1- 1480 ft. S. & 1240 ft. E; #2-2170 ft. S. & 1040 ft. E.; #3-1750 ft. S. & 80 ft. E.; ALL from the N.W. cor. A. Smith D.L.C. #69. Clear Lake Div. Pt. located 1960 ft. W. & 700 ft. S.; Clagget Cr. Div. Pt. located 310 ft. W. & 1280 ft. S.; Oldenburg well located 20 ft. E. & 580 ft. S. All from the N.E. cor. A Smith D.L.C. #69.

FINAL PROOF SURVEY
UNDER

Application No. G 2271 Permit No. G 2083 27951

IN NAME OF

GORDON TURNIDGE

Surveyed Oct. 19. 1966., by V. GARNER

1966-D