


T. 7S. R. 1E. W. M.

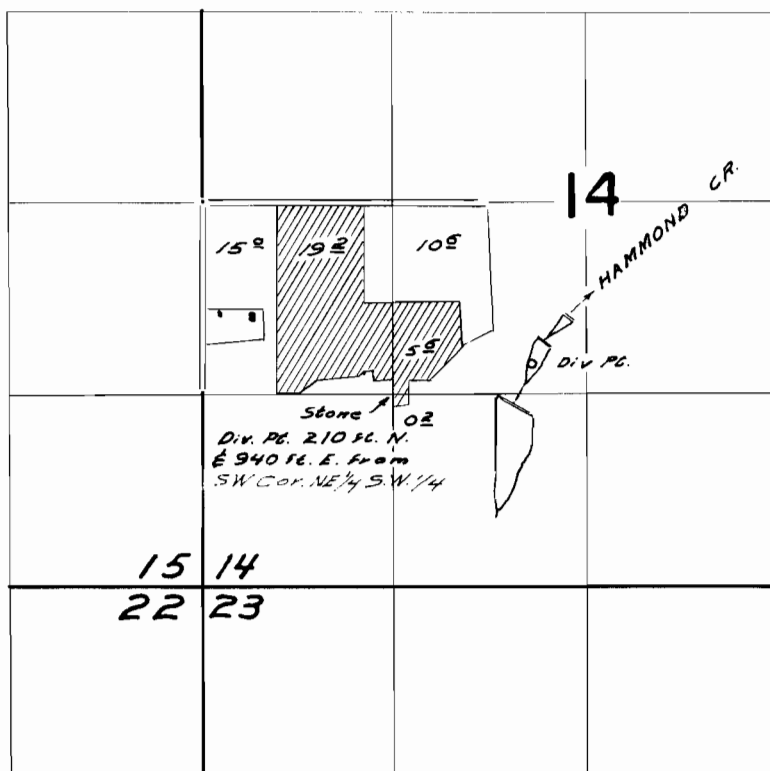

**FINAL PROOF SURVEY**  
UNDER

Application No. 37163 Permit No. 28101  
IN NAME OF

*Lawrence W. Zach*

Surveyed May 23 1966, by W. J. Ruppert