


T.9S.R.3W.W.M.

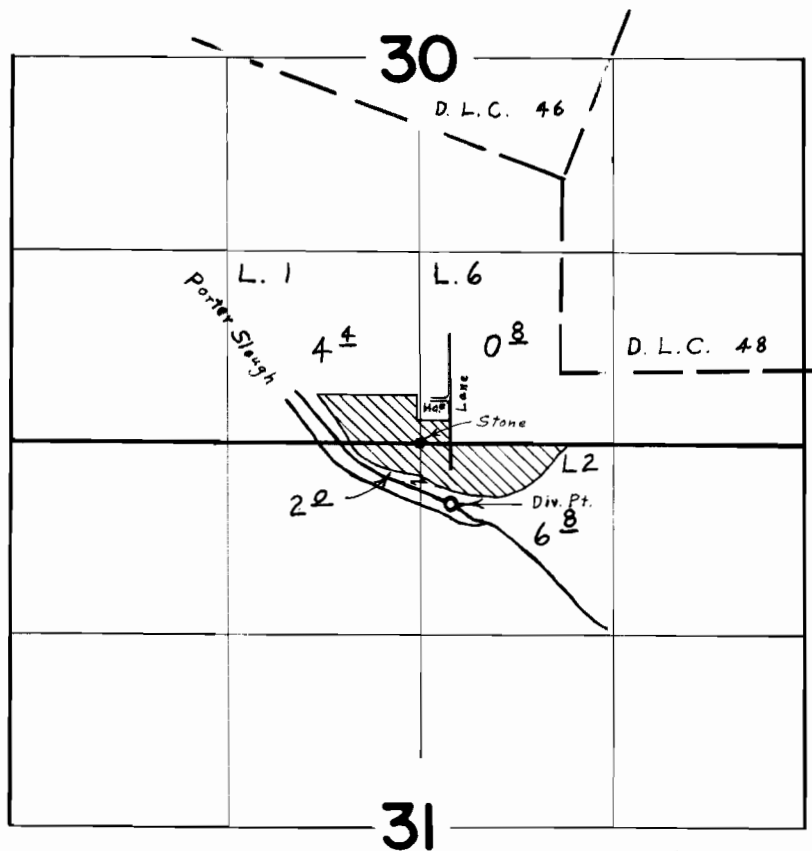

Div. Pt. Located 410' S. & 210' E. From the N.  $\frac{1}{4}$  Cor. Sec. 31

**FINAL PROOF SURVEY**  
UNDER

Application No. 41595 Permit No. 31024  
IN NAME OF

ARTHUR J. AND ENID M. BLAKENEY

Surveyed Sept. 9 1966, by L. E. Gould