


# T. 3S. R. 9W. W.M.

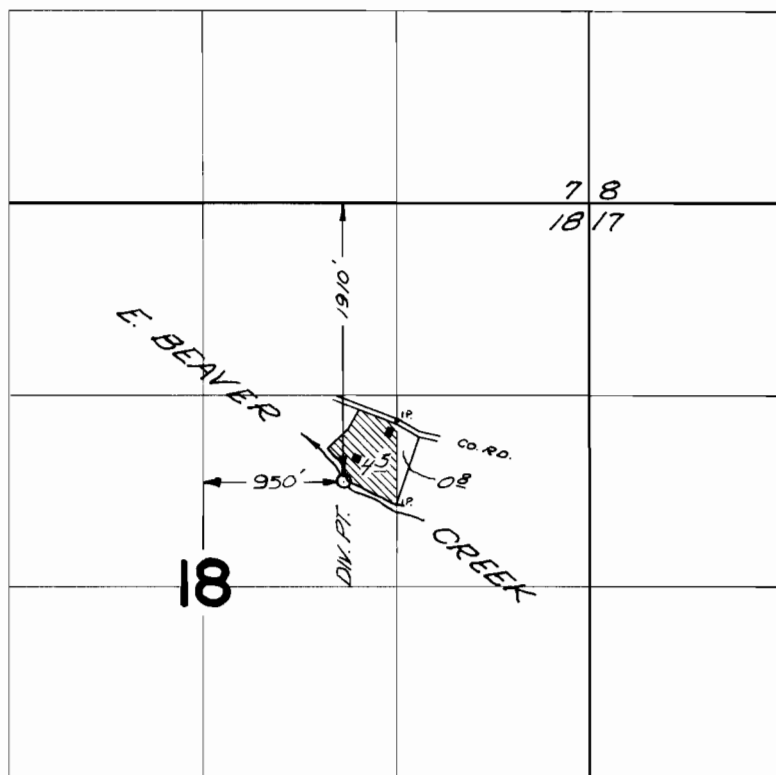

## FINAL PROOF SURVEY UNDER

Application No. 39855 Permit No. 29668  
IN NAME OF

FRANKLIN E. RICHMAN

Surveyed Sept 26 1967, by V. Garner