


T.3S. R.9W. W.M.

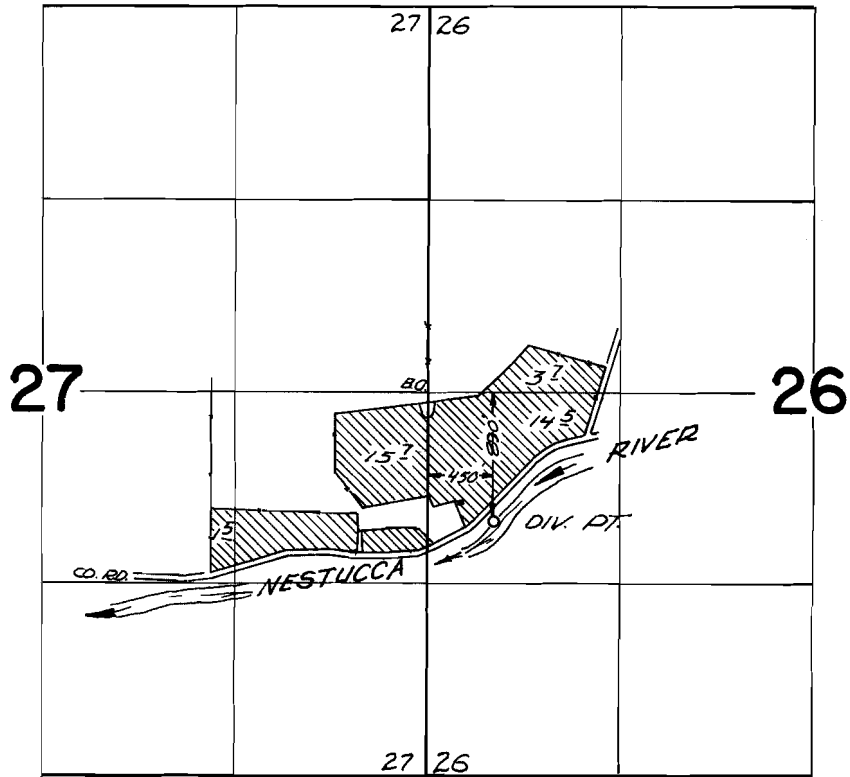

FINAL PROOF SURVEY UNDER

Application No. 40442 Permit No. 30148
IN NAME OF

QUENTIN BORBA

Surveyed Sept. 28 1967, by V. Garner