


T.2 & 3 S. R. 39 E. W.M.

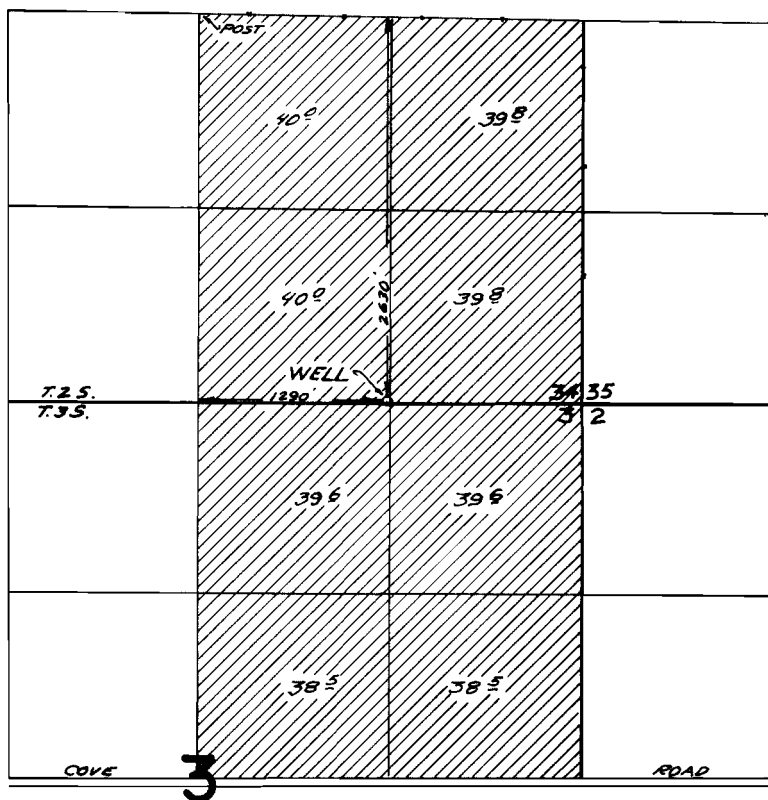

FINAL PROOF SURVEY UNDER

Application No. G-2930 Permit No. G-2784
IN NAME OF

CLAUDE ANSON

Surveyed Aug. 25, 1967, by V. Garner