


T.3S. R.40E. W.M.

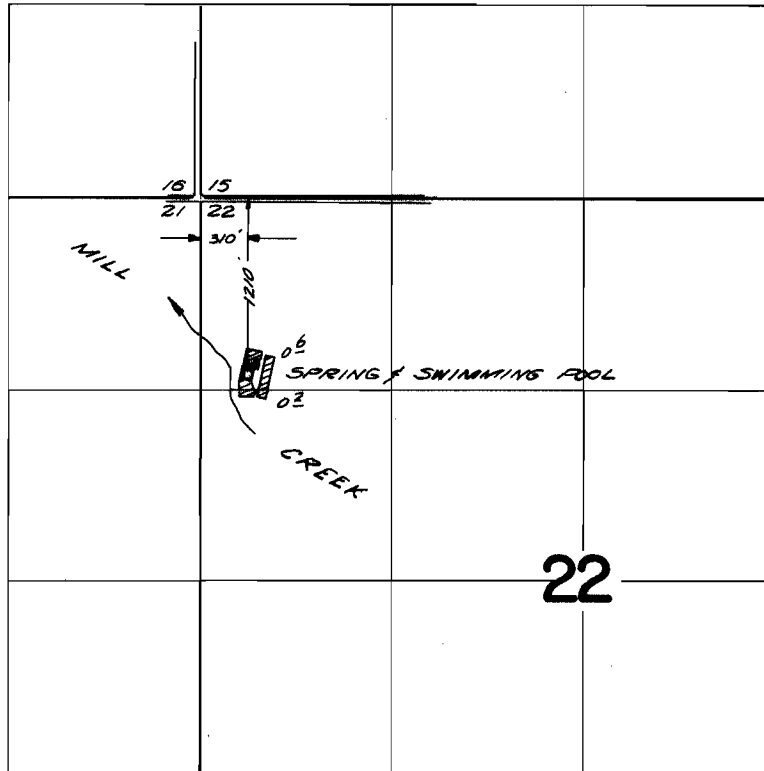

FINAL PROOF SURVEY UNDER

Application No. 38349 Permit No. 28582
IN NAME OF

DEAN PUCKETT and ESTELLA PUCKET

Surveyed Aug 30, 1967, by V. Garner