


T. 6 N. R. 35 E. W. M.

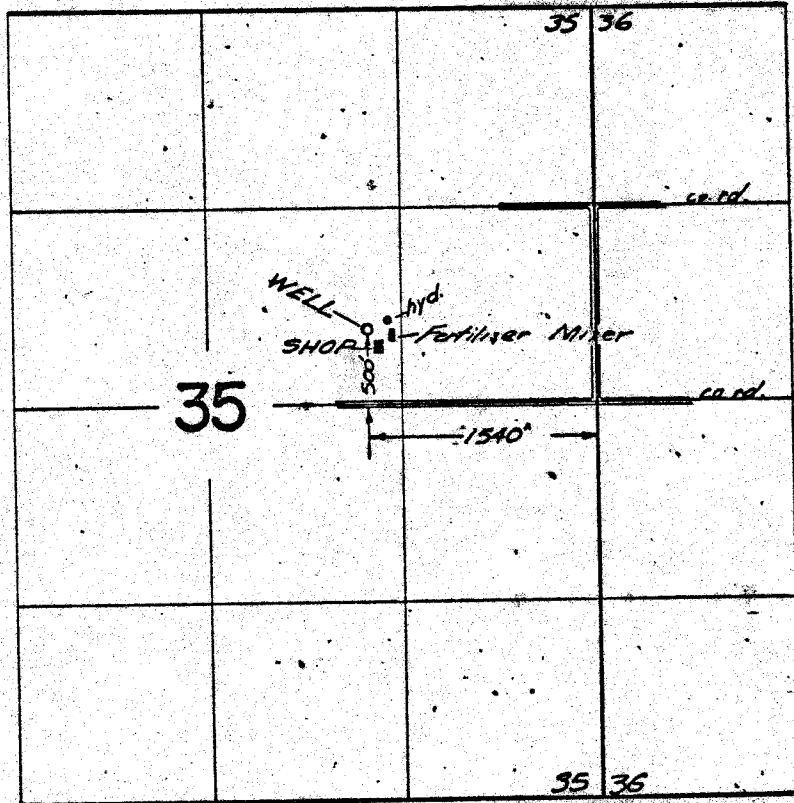

FINAL PROOF SURVEY UNDER

Application No. G1871 Permit No. G1733
IN NAME OF

YORK FERTILIZER COMPANY INC.

Surveyed Oct. 25 1966, by V. GARNER