


T.2 N. R.47E. W.M.

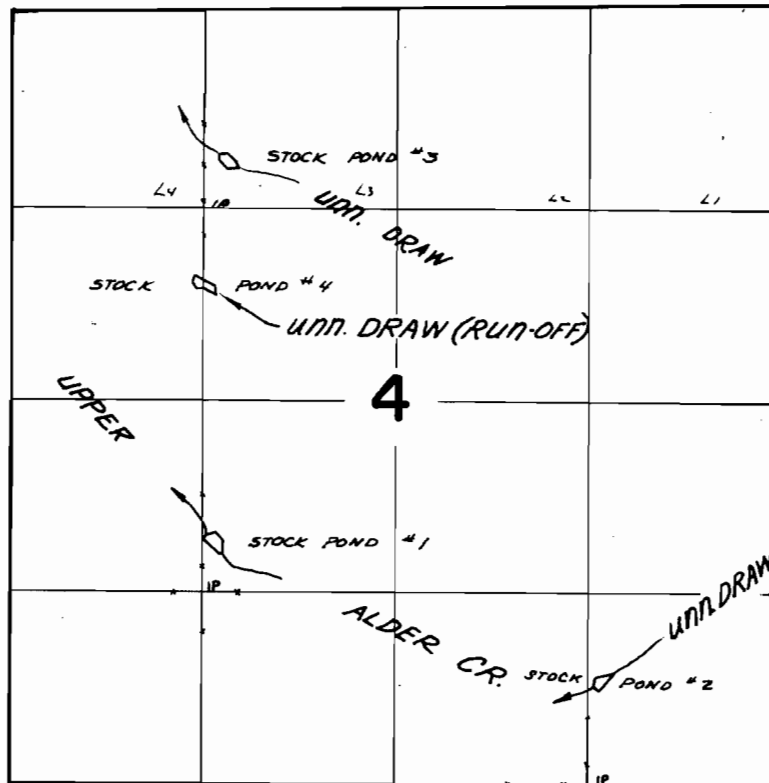

FINAL PROOF SURVEY
UNDER

Application No. R-40800 Permit No. R-4579
IN NAME OF

JOHN W. and LOUISE M. PURVIS,

Surveyed Oct. 7, 1967, by V. Garner