


T.2S. R.45 E. W.M.

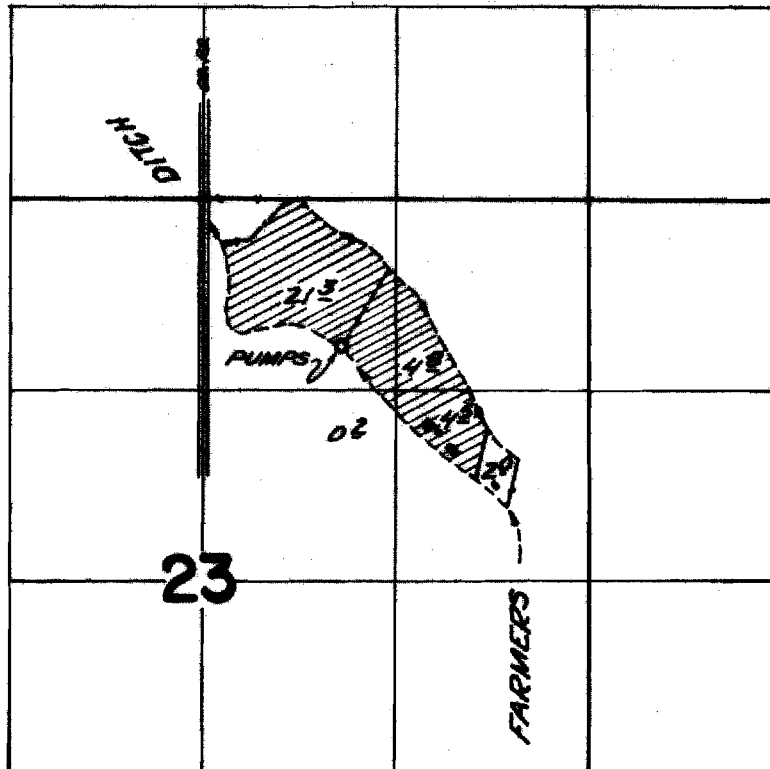

**FINAL PROOF SURVEY
UNDER**

Application No. 40784 Permit No. 30392
IN NAME OF

LESTER L. ROBINSON

Surveyed Oct. 6 1967, by V. Garner