R-4541
30247

T.5 S. R.12 E. W.M.

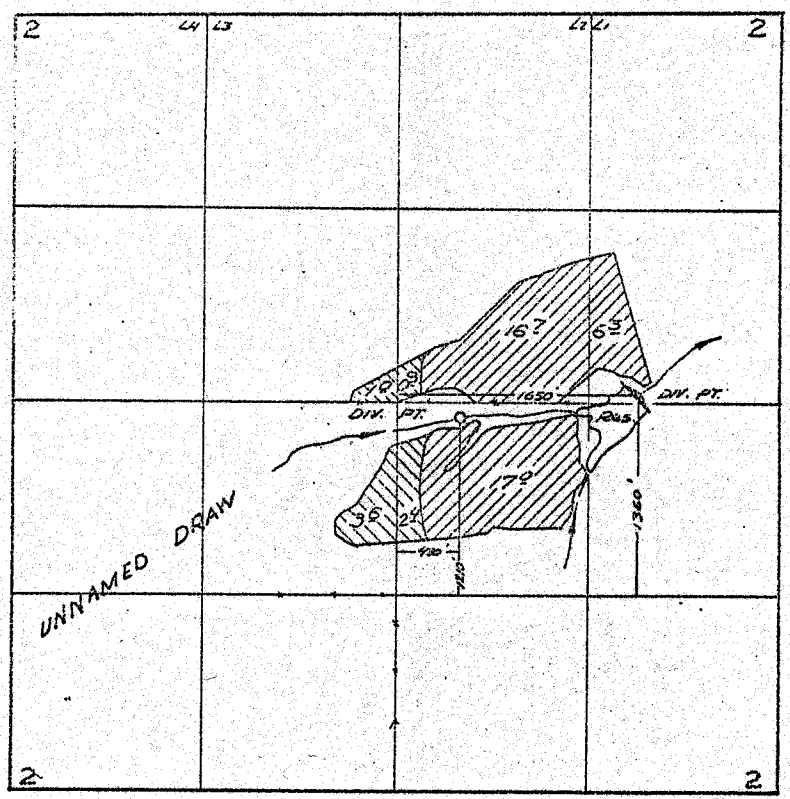

FINAL PROOF SURVEY

UNDER

UNNAMED DRAW & RES.

UNNAMED DRAW ONLY

R 40643 R 4541

Application No. 40644 Permit No. 30247

IN NAME OF

GEORGE S. GRAY.

Surveyed Nov. 8 1967, by V. Gocner

1967-F