



R-4541  
30247

# T.5 S. R.12 E. W.M.

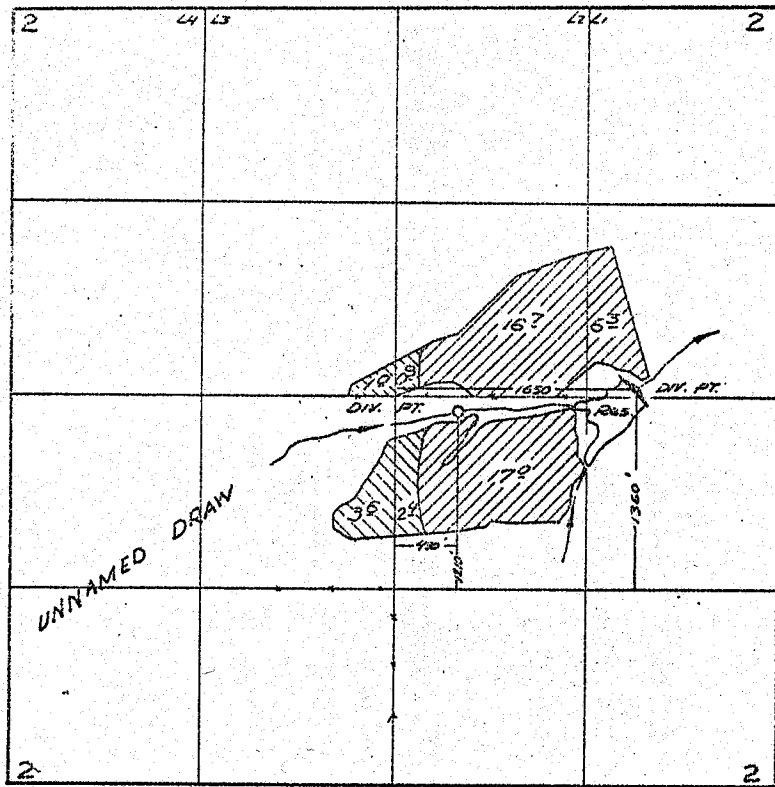

## FINAL PROOF SURVEY

UNDER

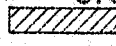 UNNAMED DRAW & RES.

 UNNAMED DRAW ONLY

R 40643 R 4541

Application No. 40644 Permit No. 30247  
IN NAME OF

GEORGE S. GRAY.

Surveyed Nov. 8 1967, by V. Gorner