


T.2S.R.2W.W.M.

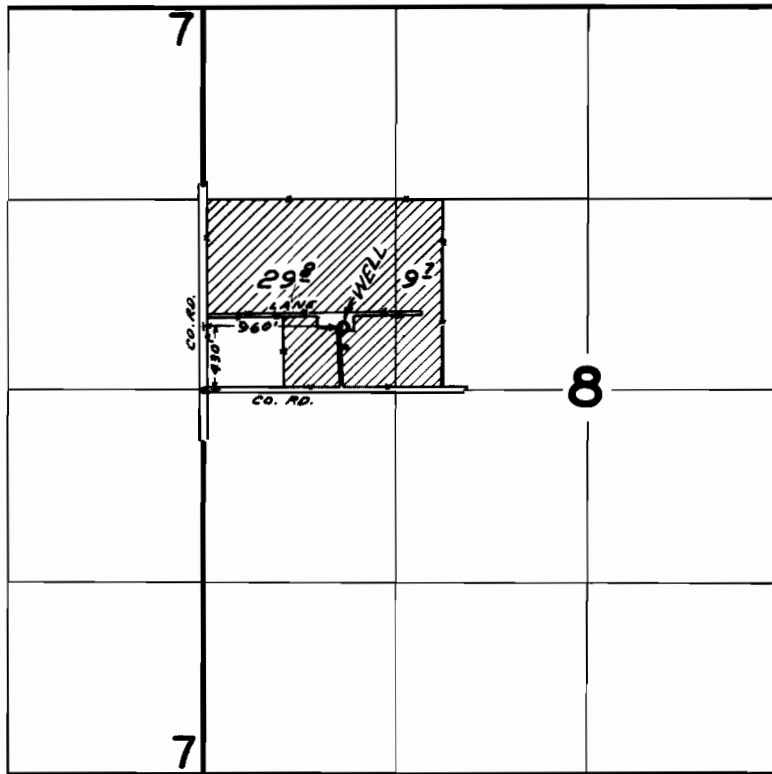

FINAL PROOF SURVEY
UNDER

Application No. G-3197 Permit No. G-3019
IN NAME OF

ROBERT C. HIATT

Surveyed SEP 12 1967, by V. GARNER