


T.2N.R.2W.W.M.

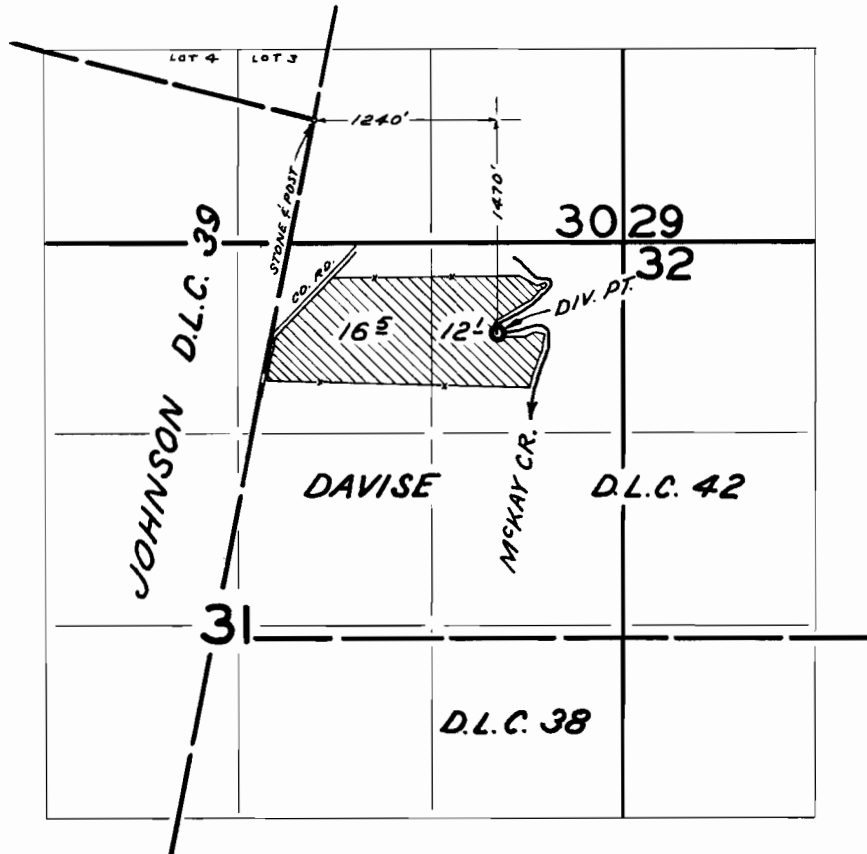

FINAL PROOF SURVEY
UNDER

Application No. 38468 Permit No. 28645
IN NAME OF

RALPH A. KEMPER

Surveyed JUN. 5 1967, by V. GARNER