


# T.1N.R. 4W.W.M.

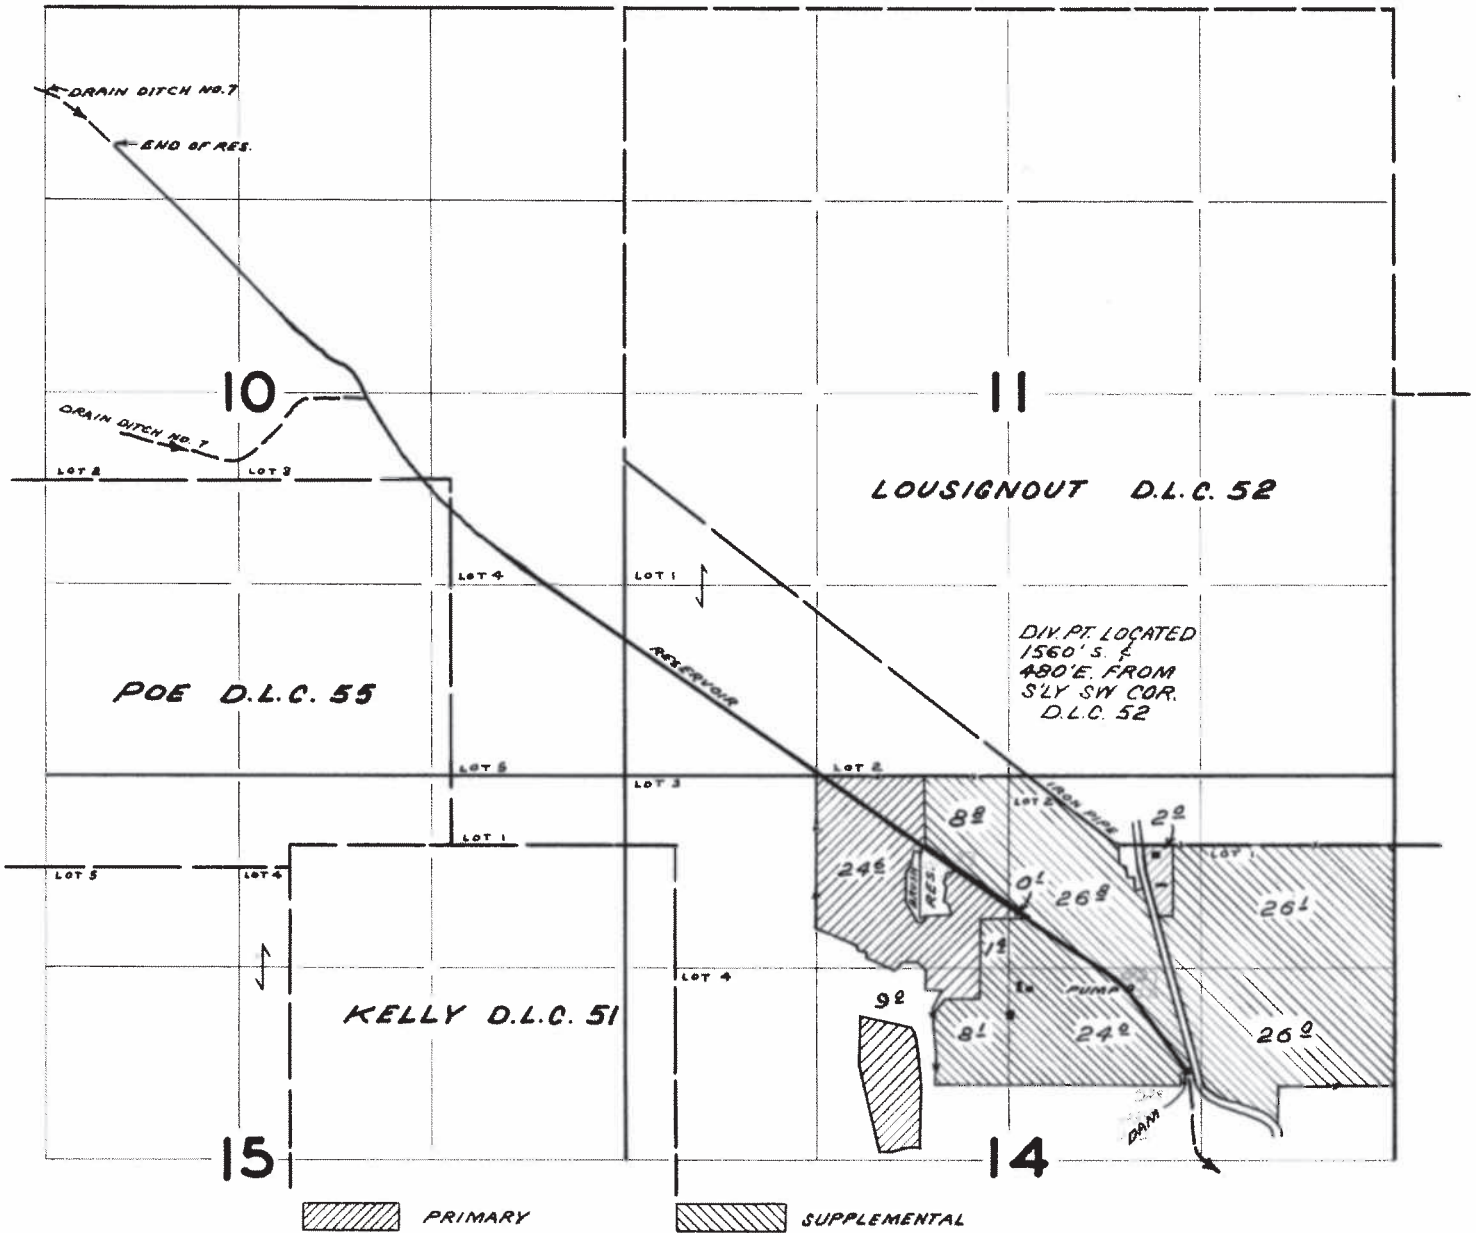

## FINAL PROOF SURVEY UNDER

Application No. R-38709 38710 Permit No. R-3264 28825

IN NAME OF

MELVIN L. LOVE

Surveyed JUN 6 1967, by V. GARNER