


T.1N.R.2&3W.W.M.

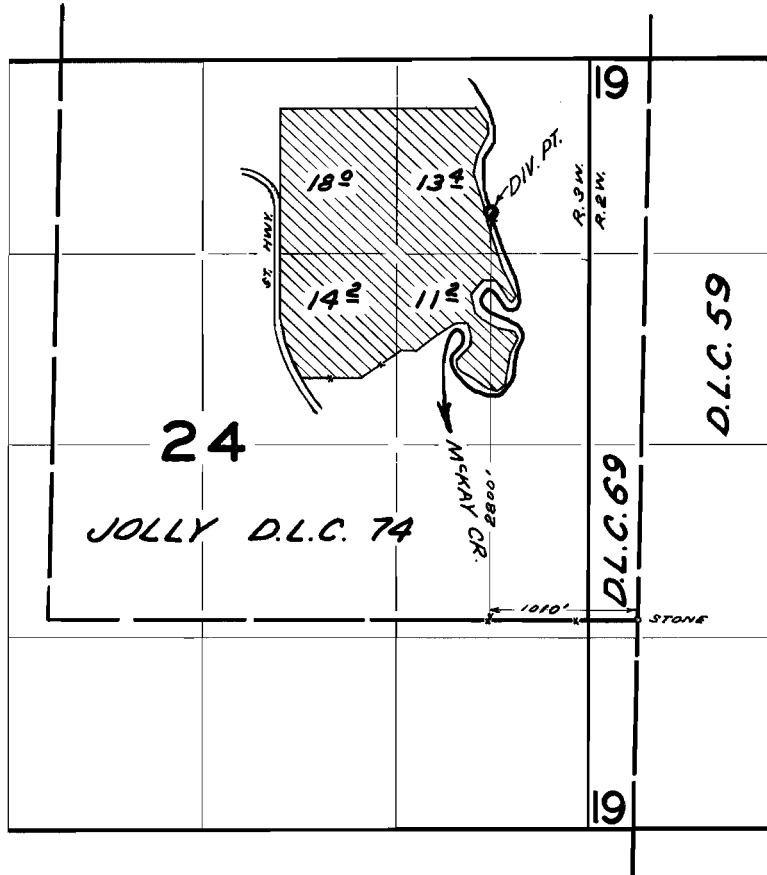

FINAL PROOF SURVEY UNDER

Application No. 40146 Permit No. 29925
IN NAME OF

CARL O. PETERSON

Surveyed MAY 8 1967, by V. GARNER