


T.2S.R.2W. W.M.

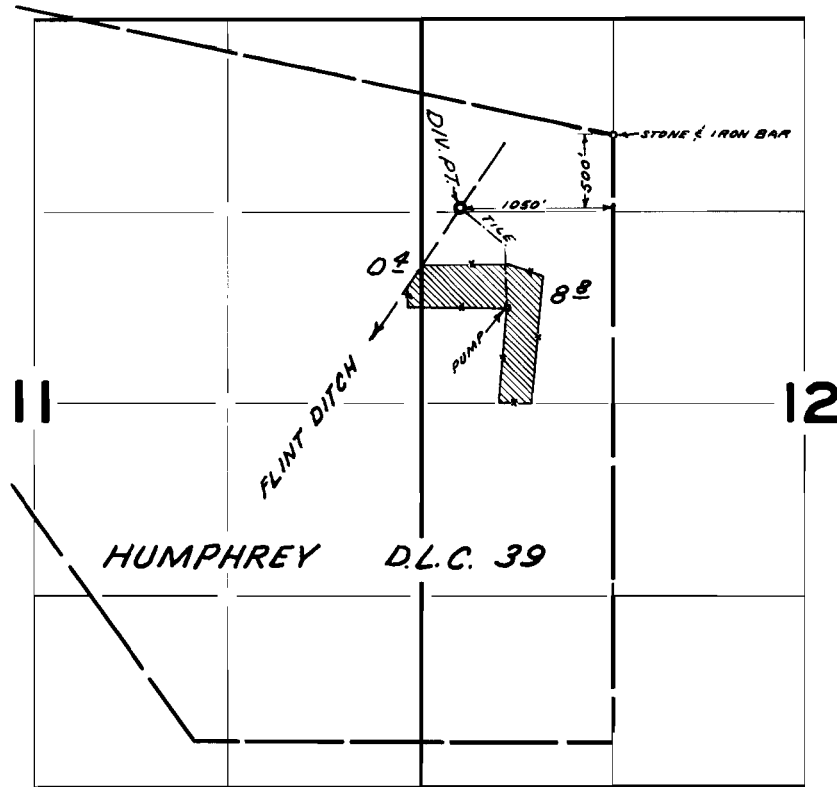

FINAL PROOF SURVEY
UNDER

Application No. 41513 Permit No. 30978
IN NAME OF

J. H. ATEN

Surveyed SEP 13 1967, by V. GARNER