


# T. 3S. R. 3W. W.M.

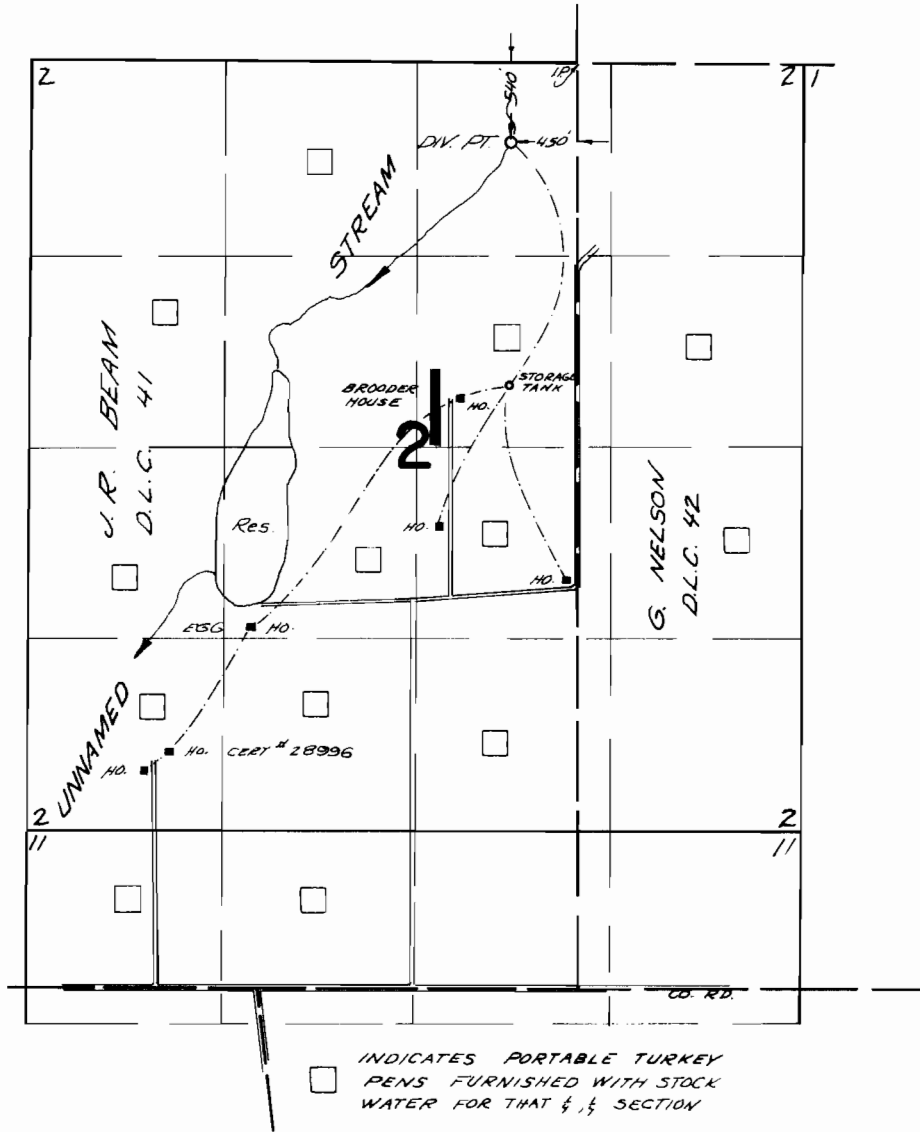

## FINAL PROOF SURVEY UNDER

Application No. 37061 Permit No. 27574  
IN NAME OF

R.L. WALKER FARMS

Surveyed Oct 17, 1967, by V. Garner