


T. 4 S. R. 5 W. W.M.

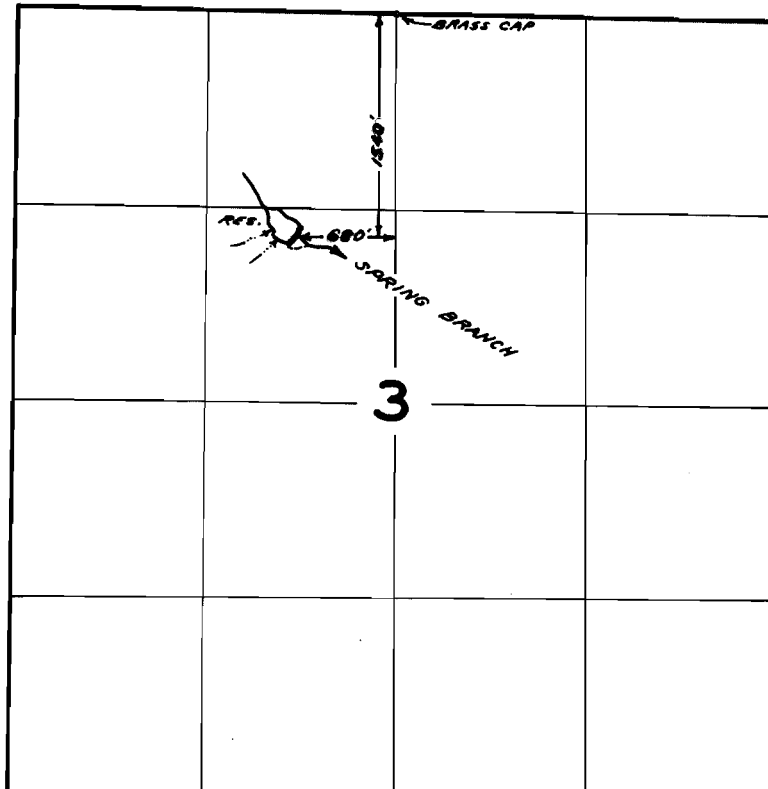

FINAL PROOF SURVEY
UNDER

Application No. R-38033 38034 Permit No. R-3146 28345
IN NAME OF

ESTATE OF O. F. ARGABRIGHT

Surveyed APR. 4 1967, by V. GARNER