


T. 3 S. R. 4 W. W. M.

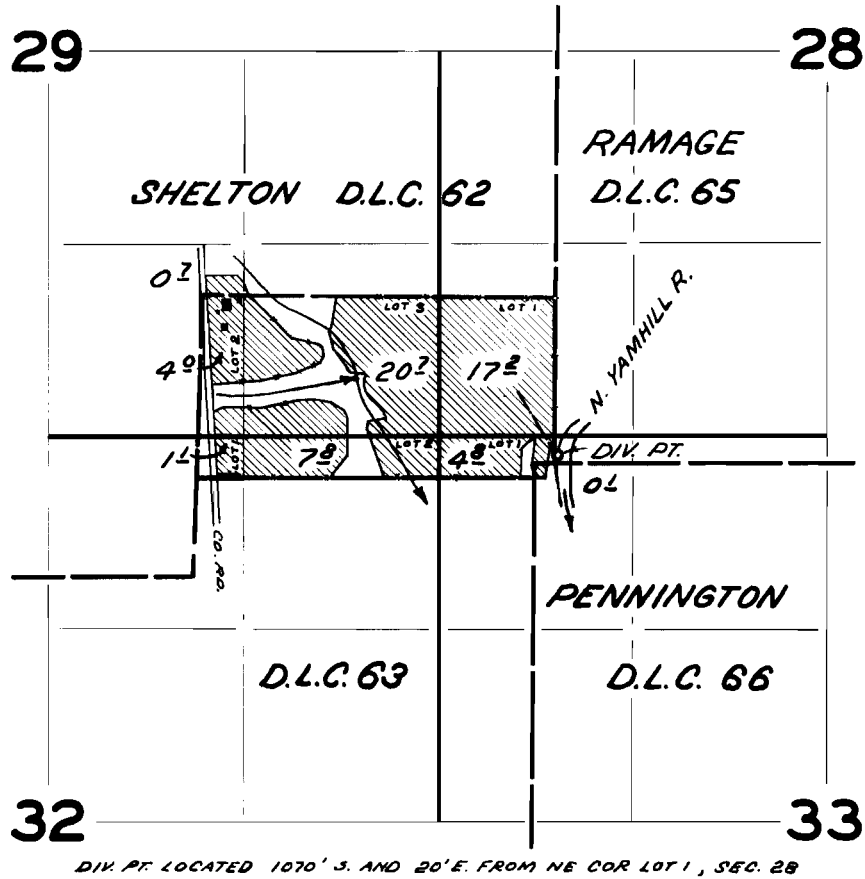

FINAL PROOF SURVEY
UNDER

Application No. 37507 Permit No. 28357
IN NAME OF

JOHN A. SITTON

Surveyed APR. 5 1967, by V. GARNER