


T. 2S. R. 3W. W.M.

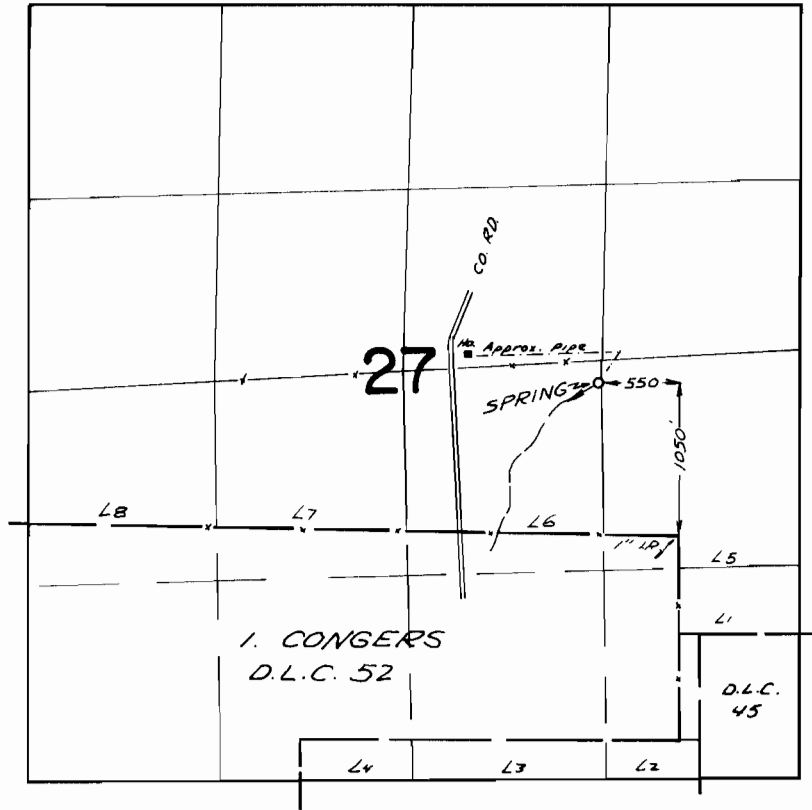

FINAL PROOF SURVEY UNDER

Application No. 38269 Permit No. 28568
IN NAME OF

R. E. and NINA W. WOODS

Surveyed Sept 6 1967, by *V. Garner*