


T. 2 S., R. 3 W., W. M.

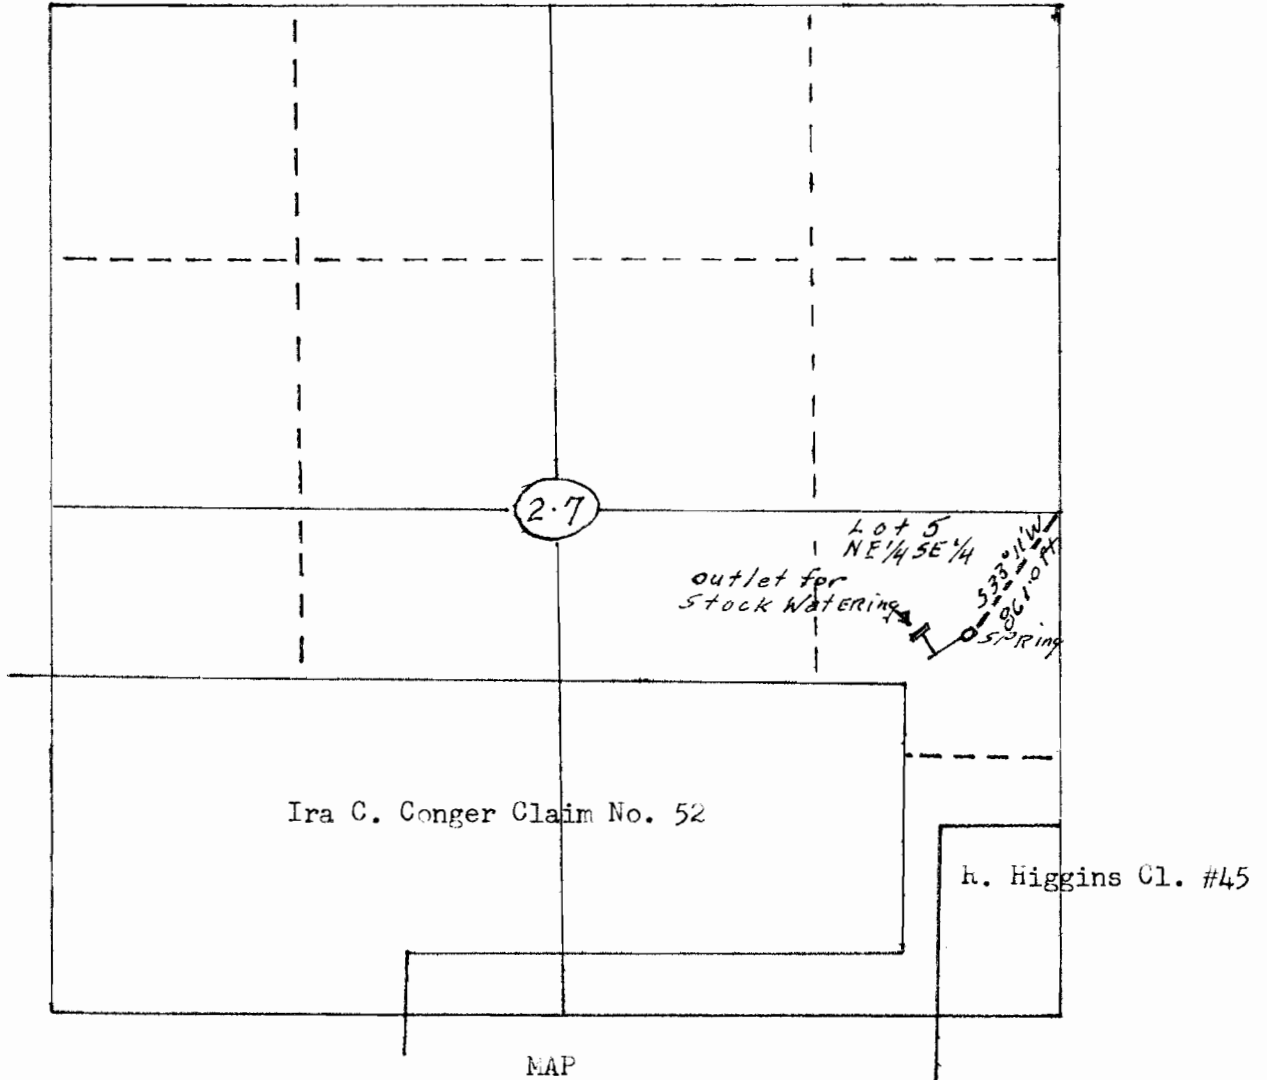

To accompany application of R. E. Wood
and Nina W. Wood for Permit to
Appropriate Water.

August 25, 1965

Application No. 41286
Permit No. 30786