


# T. 4S. R. 5W. W.M.

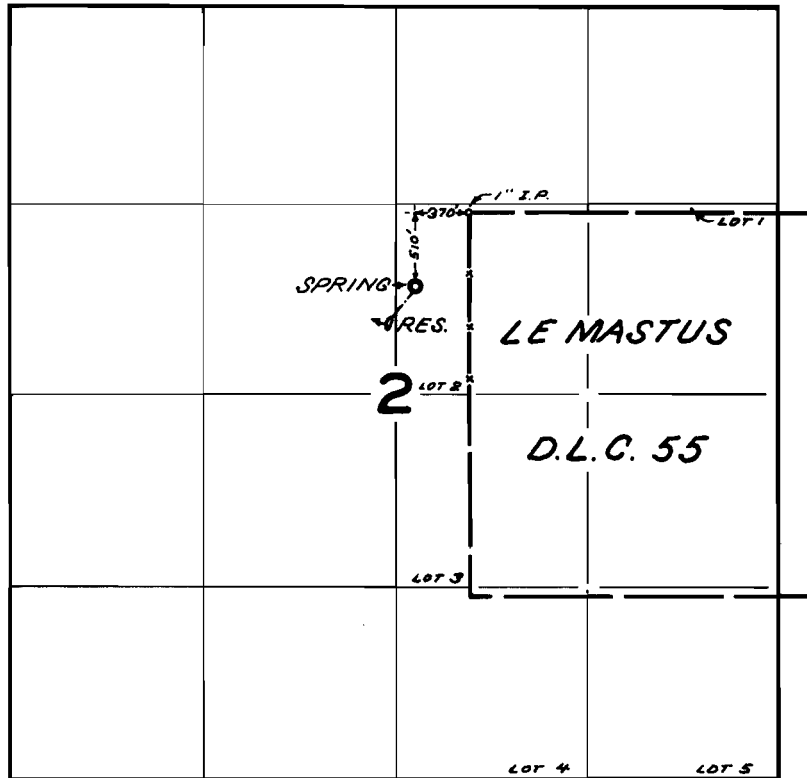

## FINAL PROOF SURVEY UNDER

Application No. 38484 ~~R. 38668~~ Permit No. 28712 ~~R. 3254~~  
IN NAME OF

ANDREW PETERSON

Surveyed AUG. 9 1967, by V. GARNER