


T. 4S. R. 5W. W.M.

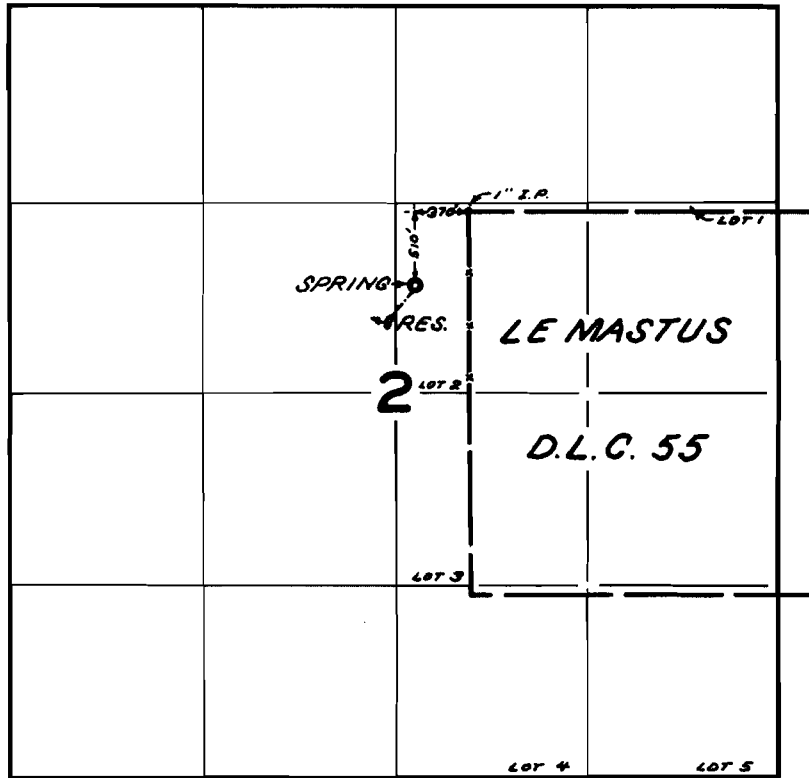

FINAL PROOF SURVEY UNDER

Application No. 38484 R. 38668 Permit No. 28712 R. 3254
IN NAME OF

ANDREW PETERSON

Surveyed AUG. 9 1967, by V. GARNER