


T. 4S. R. 3W. W.M.

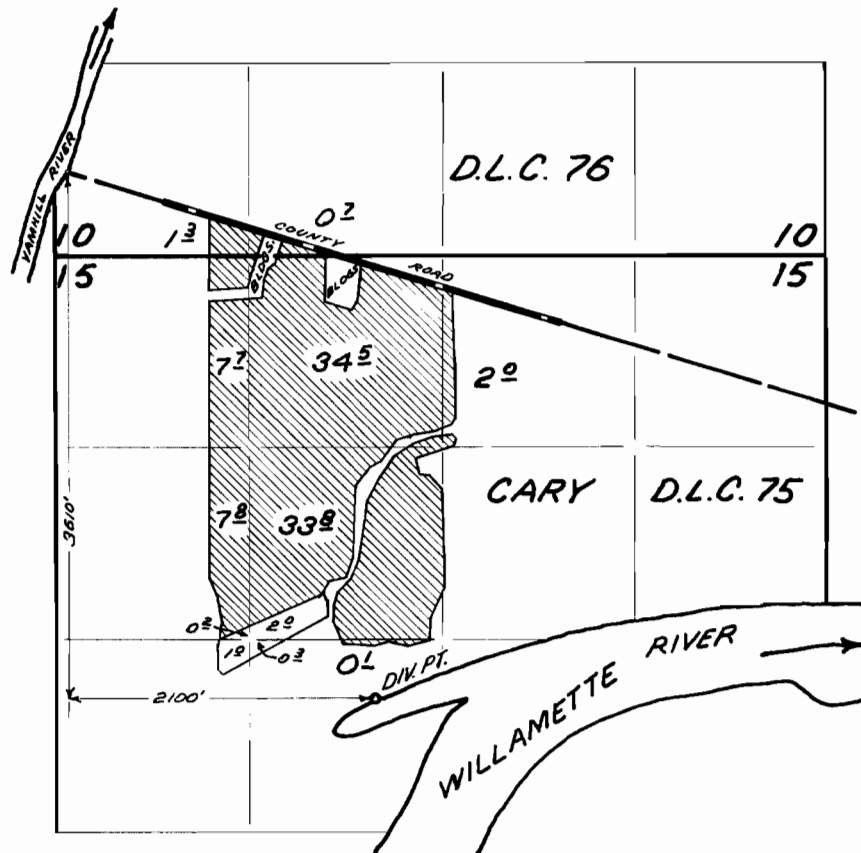

**FINAL PROOF SURVEY**  
UNDER

Application No. 38656 Permit No. 28767  
IN NAME OF

ROBERT E. COBURN

Surveyed JUN 1 1967, by V. GARNER