


T. 3S. R 2W. W.M.

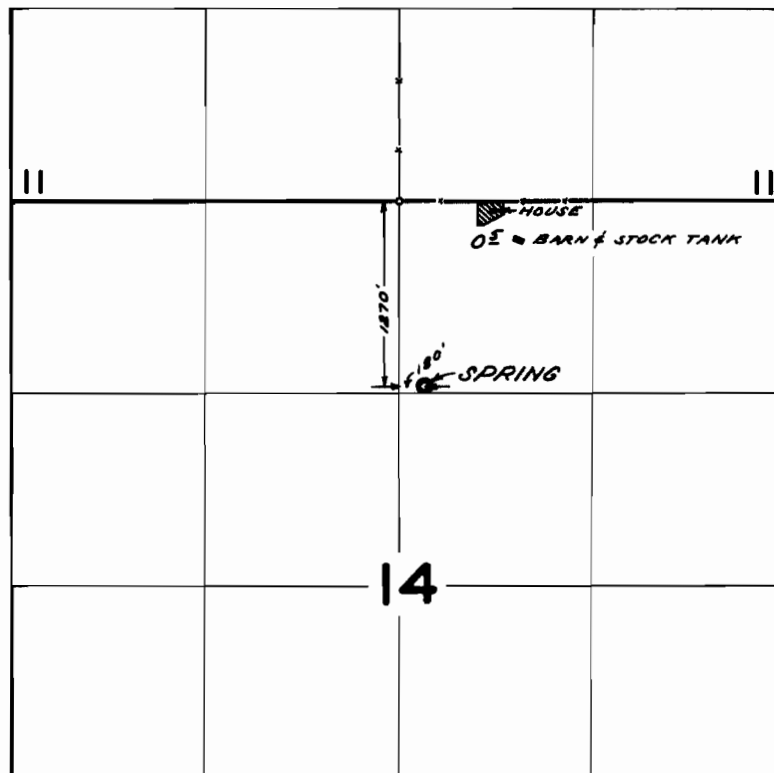

**FINAL PROOF SURVEY**  
UNDER

Application No. 42106 Permit No. 31194  
IN NAME OF

EARL AND MARGARET L. KNIGHT

Surveyed JUN 2 1967, by V. GARNER