


T. 4S. R. 5W. W.M.

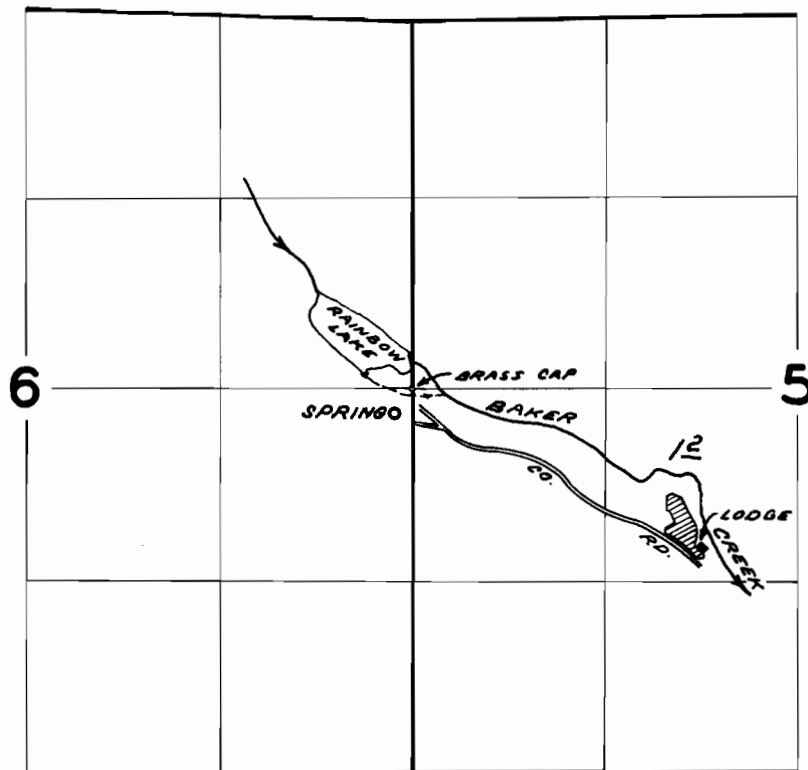

DIV. PTS. LOCATED :  
RES. - 180' N. & 20' W., SPRING - 170' S. & 130' W.  
BOTH FROM W. 1/4 COR. SEC. 5

**FINAL PROOF SURVEY**  
UNDER

Application No. R-41338 41340 Permit No. R-4754 31278  
IN NAME OF

YAMHILL COUNTY

Surveyed APR 14 1967, by V. GARNER