


T. 3 S. R. 2 W. W. M

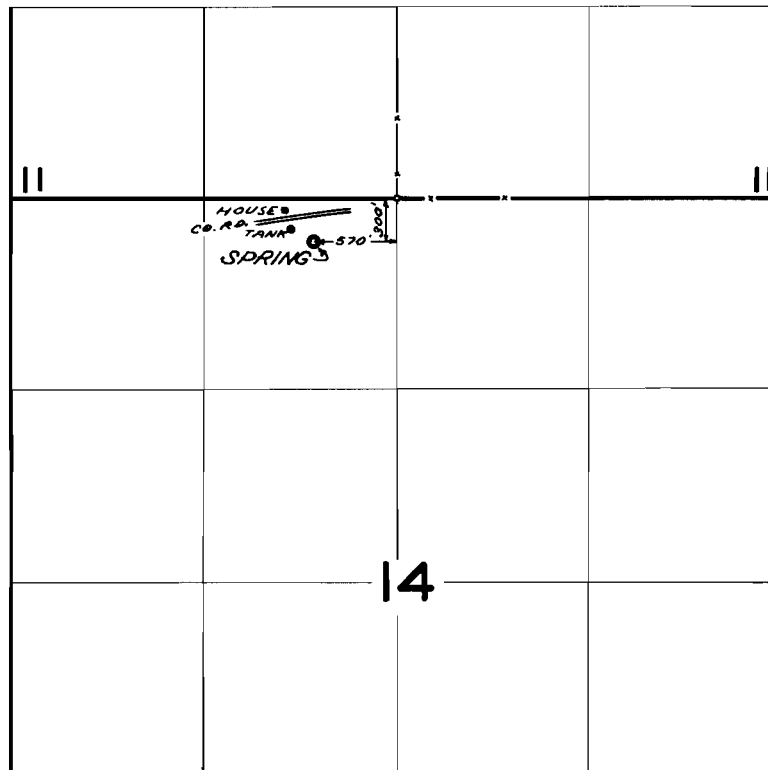

FINAL PROOF SURVEY
UNDER

Application No. 42413 Permit No. 31672
IN NAME OF

HAROLD L. HAUGEN

Surveyed JUN. 2 1967, by V. GARNER