


T. 4S. R. 1E. W.M.

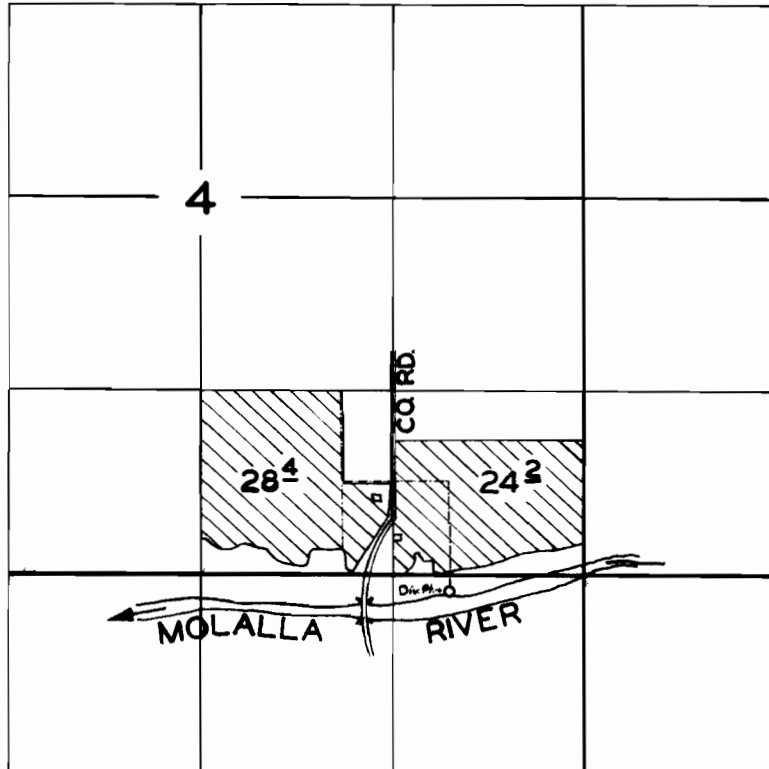

FINAL PROOF SURVEY
UNDER

Application No. 26773 Permit No. 20937
IN NAME OF

OWEN DALEN & ALFRED CHRISTENSON

Surveyed 23 MAR 1956, by R. D. BEST